



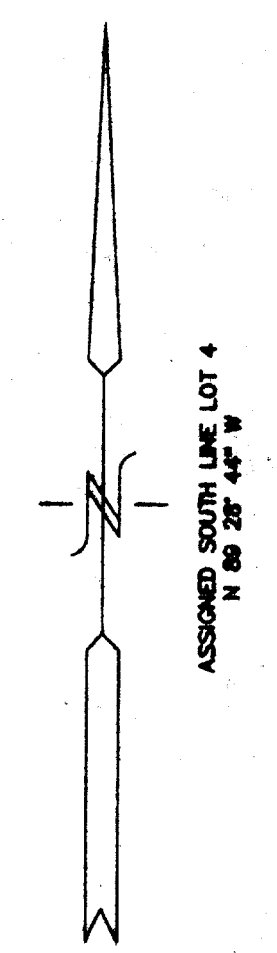


PLAT OF SURVEY  
 LOTS 4, 5, 6 & 7 OF BLOCK 17  
 WOODALE ADDITION SUBDIVISION  
 LOCATED IN THE EAST 1/2 OF THE NORTHWEST 1/4  
 SECTION 16, TOWN 1 NORTH, RANGE 16 EAST,  
 TOWN OF LINN, WALWORTH COUNTY, WISCONSIN

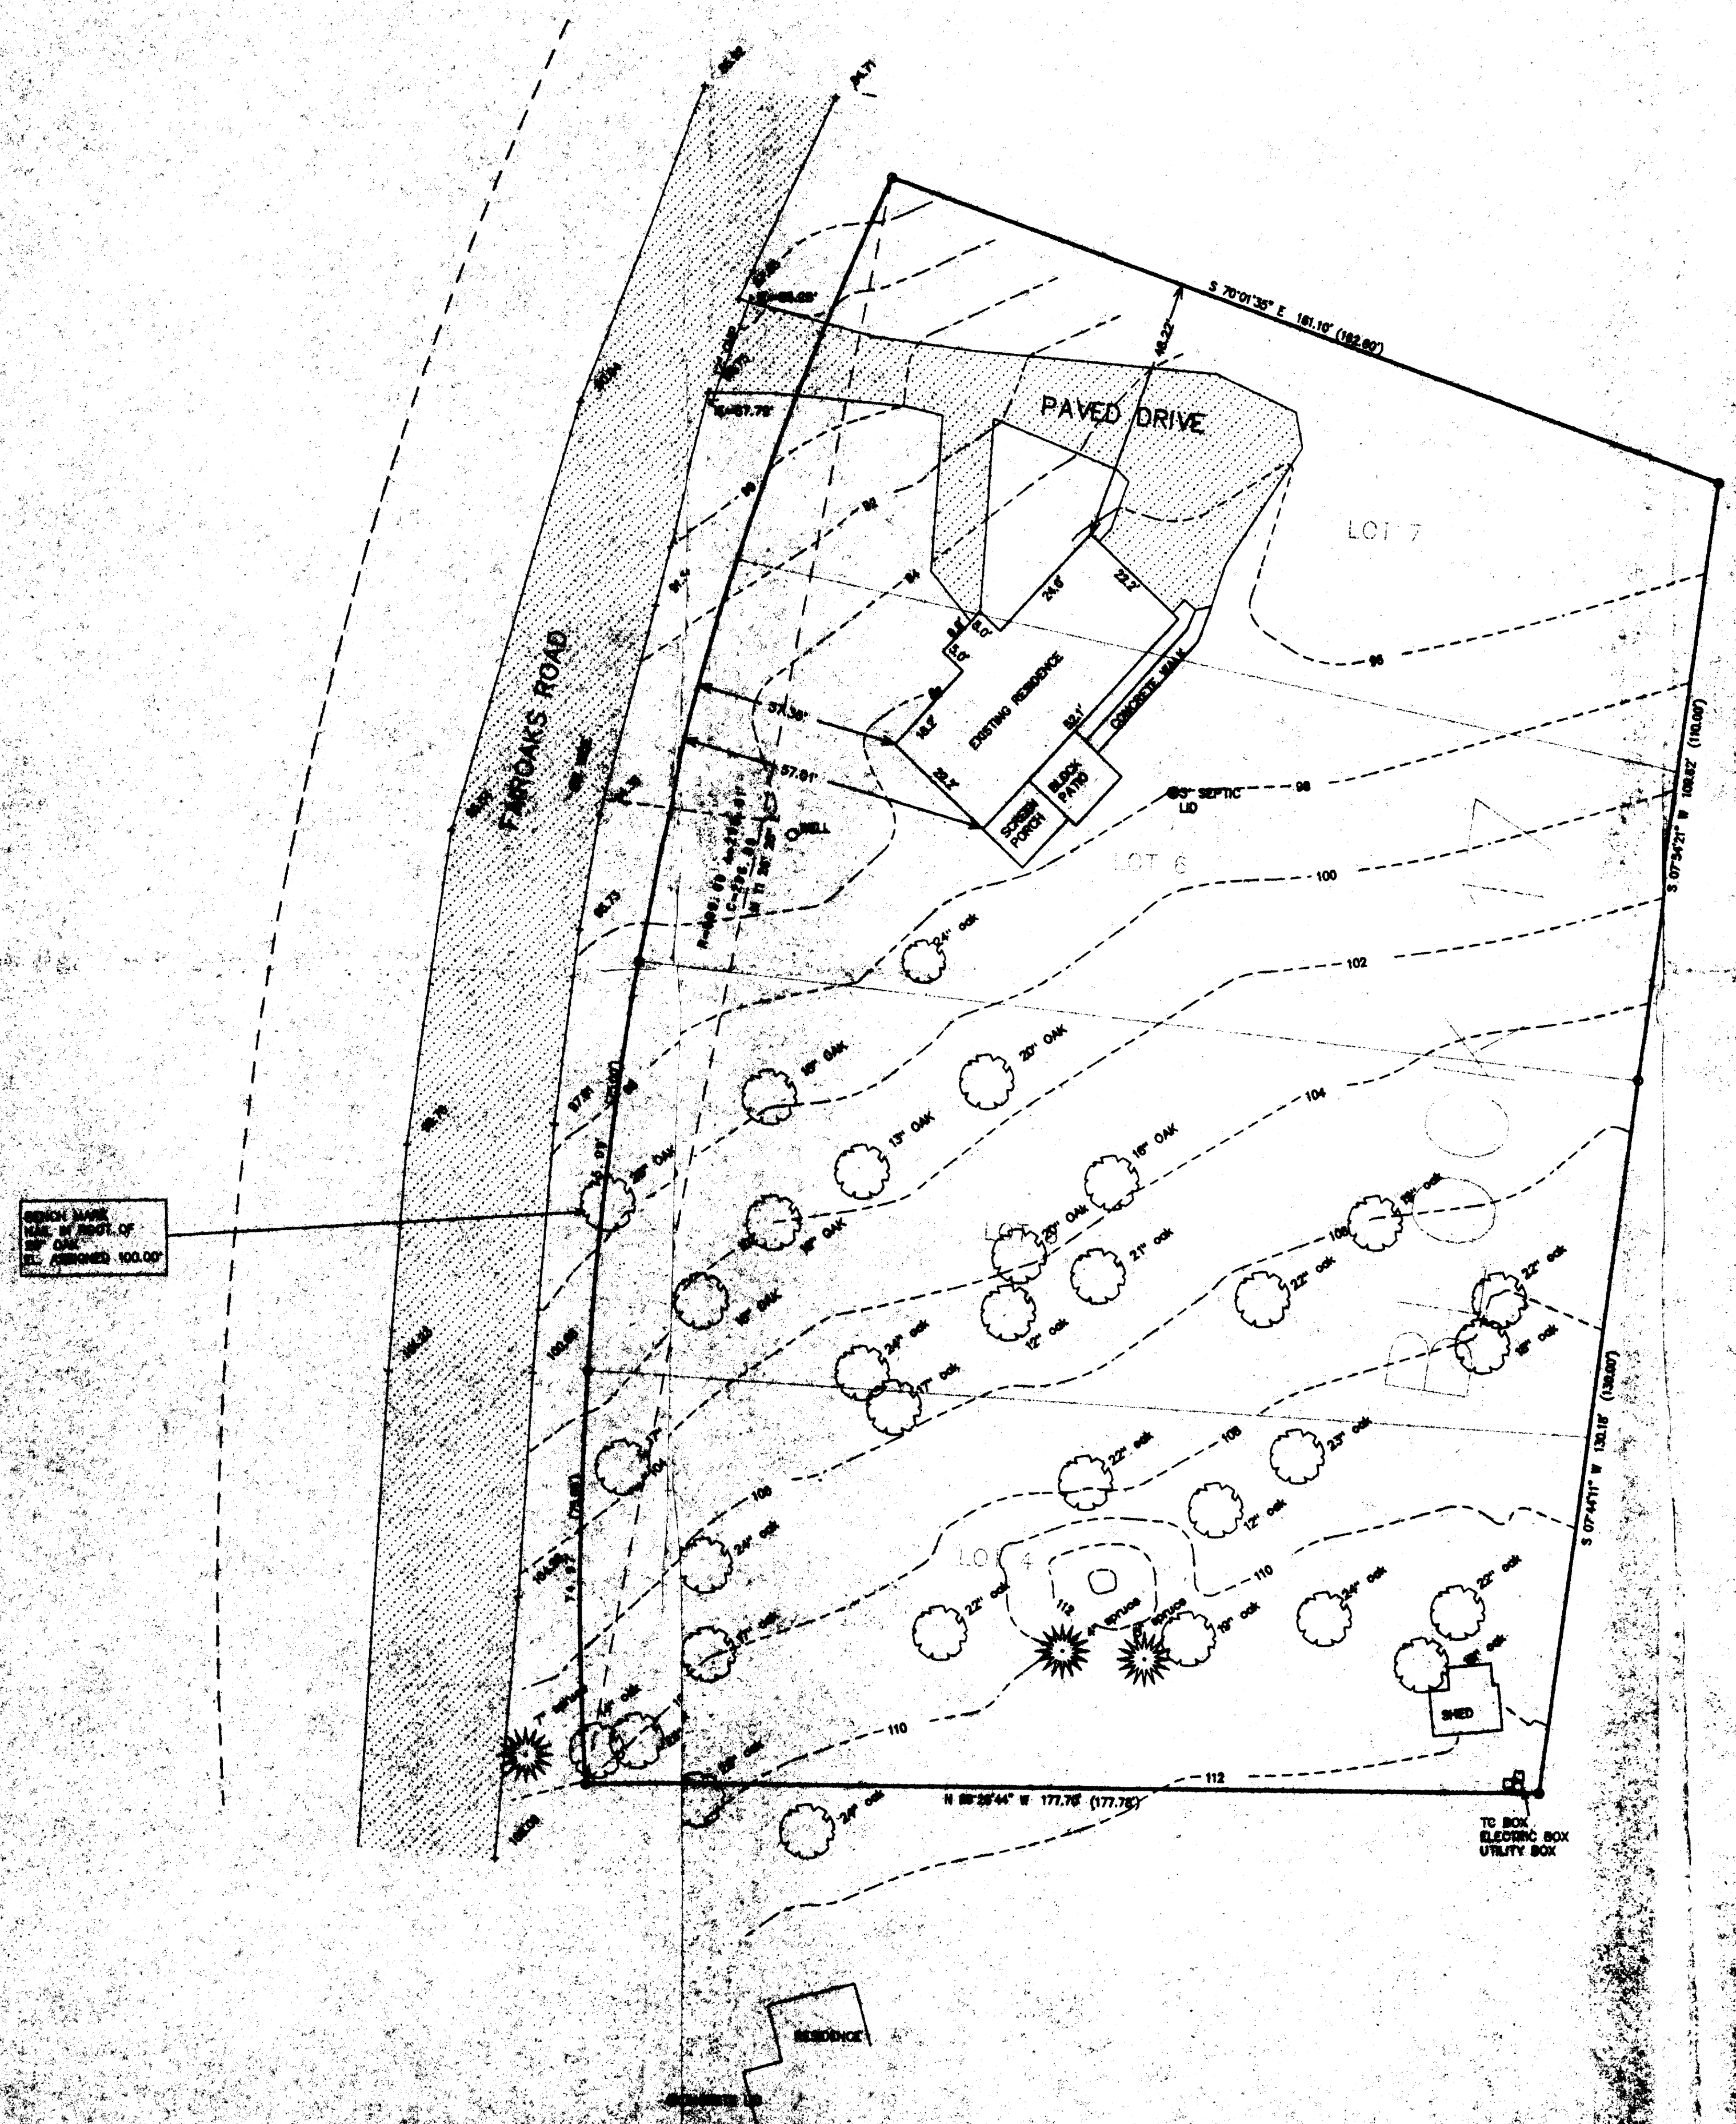

LEGEND



- = FOUND IRON PIPE
- (000) = RECORDED AS

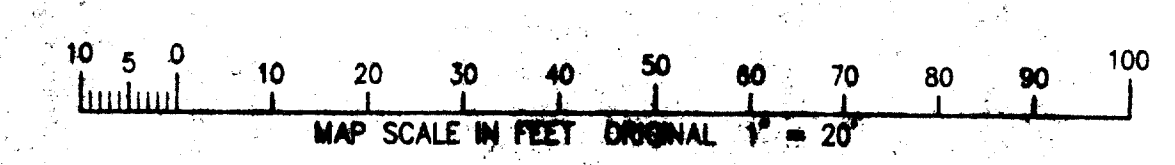

NOTE: COPIES OF THIS MAP TO WHICH THE FOLLOWING CONDITIONS WILL APPLY ARE BLUE-LINE PRINTS SHOWING SURVEYOR'S ORIGINAL SEAL AND SIGNATURE IN BLACK INK. COPIES OF ANY PERMISSIONS MADE OR ALTERATIONS WHICH DO NOT REPRESENT THE SURVEYOR'S WORK PRODUCTS.

I HEREBY CERTIFY THAT THE ABOVE DESCRIBED PROPERTY HAS BEEN SURVEYED UNDER MY DIRECTION AND THAT THE ABOVE MAP IS A TRUE REPRESENTATION THEREOF AND SHOWS THE TRUE AND LEGAL BOUNDARIES OF THE PROPERTY AND THE EXTERIOR BOUNDARIES. THIS SURVEY IS MADE FOR THE USE OF THE PRESENT OWNERS OF THE PROPERTY AND ALSO FOR THE PURPOSES OF PURCHASE, MORTGAGE, OR GUARANTEE THE TITLE THEREOF WITHIN ONE YEAR FROM THE DATE HEREIN.

DATED: 7-2-98  
 PETER S. GORDON  
 PETER S. GORDON, INC. 2101

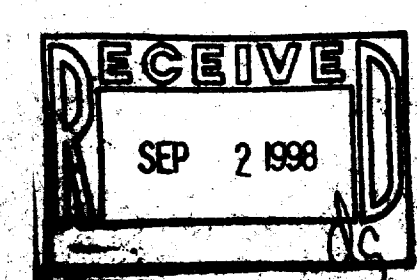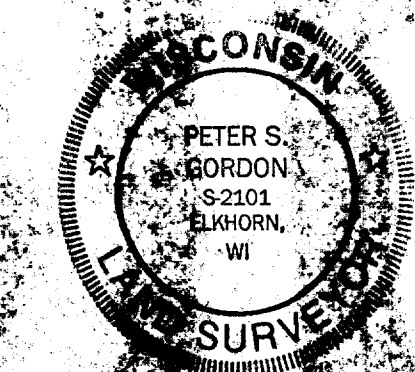

WORK ORDERED BY:  
 ARTHUR & MARILYN AUSTIN  
 N 1538 FAIR OAKS ROAD  
 LAKE GENEVA, WI 53147

FAIRNS, HANSEN & ASSOCIATES, INC.  
 Engineering, Architecture, Surveying  
 7 Ridgeway Court P.O. Box 437  
 ELKHORN, WISCONSIN 53121  
 Office: (414) 723-2098  
 Fax: (414) 723-5088