
ABELL SURVEYING & MAPPING

DELAVAN. WISCONSIN 53115 414-728-6737

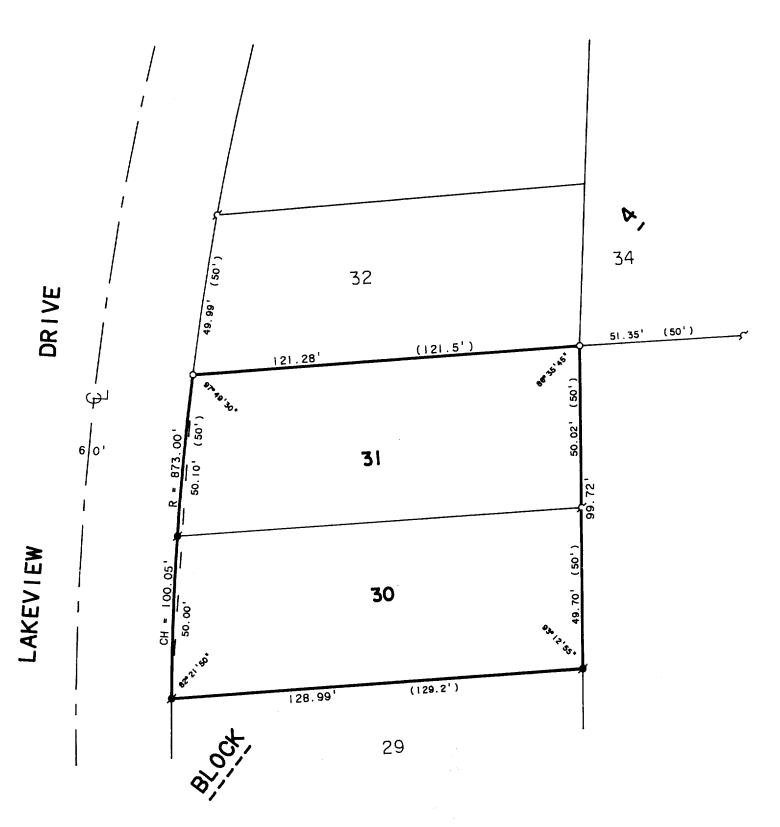

PLAT OF SURVEY OF

LOTS 30 AND 31. BLOCK 4 OF LAKE VIEW PARK. LOCATED IN TIN. RITE, WALWORTH COUNTY, WISCONSIN.

SCALE I "= 30' LEGEND

O -IRON PIN FOUND. SET IRON PIPE, FOUND 12/2/93

~ - IRON PIN FOUND # - IRON ROD FOUND)-RECORDED AS

ORDERED BY: KEEFE REAL ESTATE

LAKE GENEVA, WI. 53147

RECERTIFIED: 10/12/98 ORDERED BY: MARK WESSELS 490 MADISON ST.

I HEREBY CERTIFY THAT I HAVE SURVEYED THE ABOVE DESCRIBED PROPERTY AND THAT THE ABOVE MAP IS A TRUE REPRESENTATION THEREOF AND SHOWS THE SIZE AND LOCATION OF THE PROPERTY, ITS EXTERIOR BOUNDARIES, THE LOCATION OF ALL VISIBLE STRUCTURES AND DIMENSIONS OF ALL PRINCIPAL BUILDINGS THEREON, BOUNDARY FENCES, APPARENT EASEMENTS, ROADWAYS AND VISIBLE ENCROACHMENTS, IF ANY, TO THE BEST OF MY KNOWLEDGE AND BELIEF.

JAN

THIS SURVEY IS MADE FOR THE USE OF THE PRESENT OWNERS OF THE PROPERTY. AND ALSO THOSE WHO PURCHASE, MORTGAGE, OR GUARANTEE THE TITLE THERETO WITHIN ONE (I) YEAR

DAVID F. ABELL WISCONSIN REGISTERED LAND SURVEYOR, S-1596

REVISED: 12/2/93

JOB NUMBER - 91190 September 16, 1991

NOTE: THIS IS NOT A CERTIFIED COPY UNLESS SEALED.

704 MAIN STREET

WALWORTH, WI 53184

117-1766