
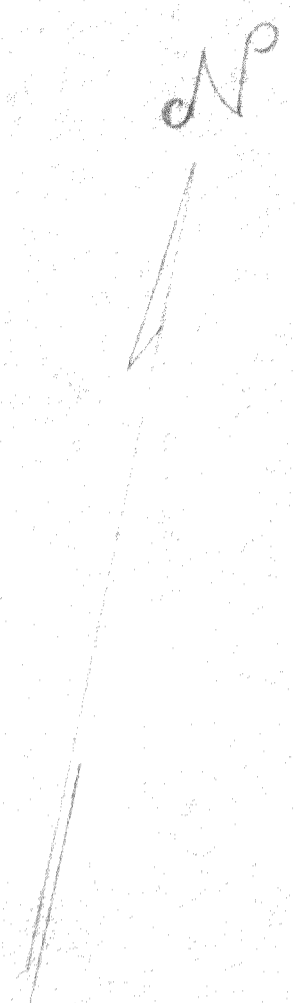


LOCATION & ELEVATIONS FOR FUTURE HOME OF
 WILLIAM HARDT
 FOREST REST SUBDIVISION

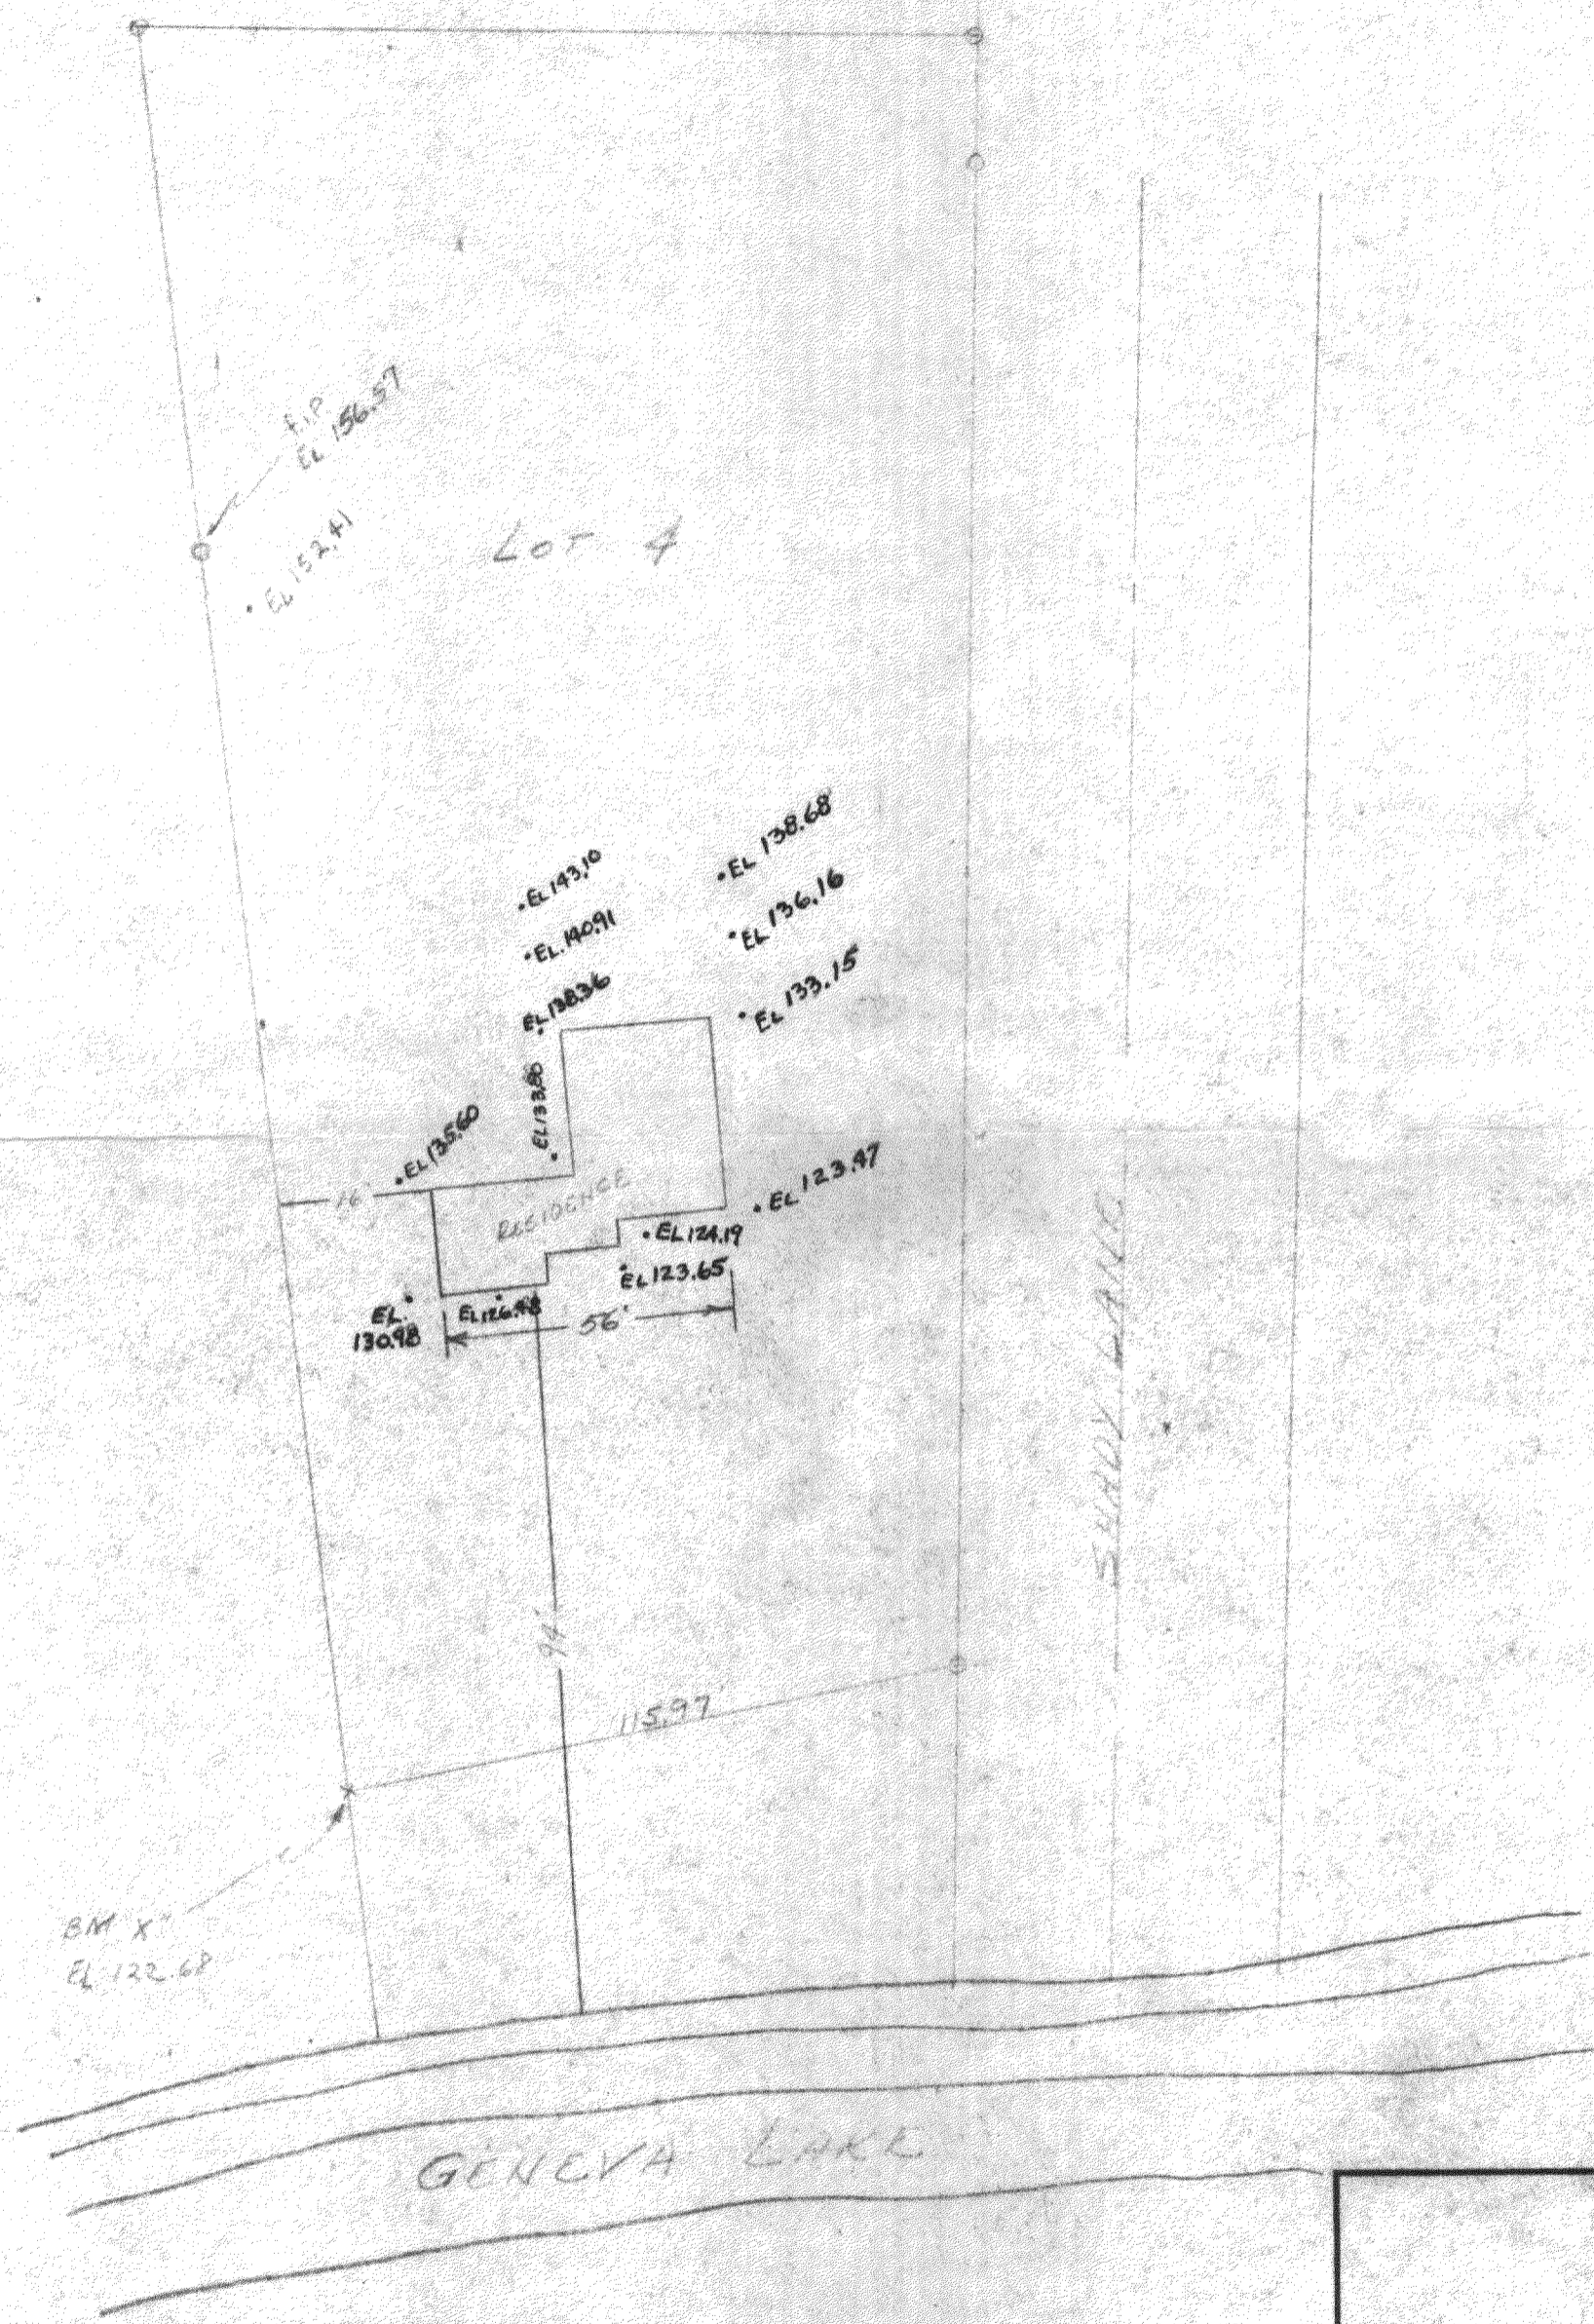

- ELEVATION STAKES
- x CROSS CUT IN CONCRETE STAKES
- o IRON PIPE

IFR-4 - proposed Bldg location

DATE Aug 57