
ABELL SURVEYING & MAPPING

DELAVAN, WISCONSIN 53115 262-728-6737



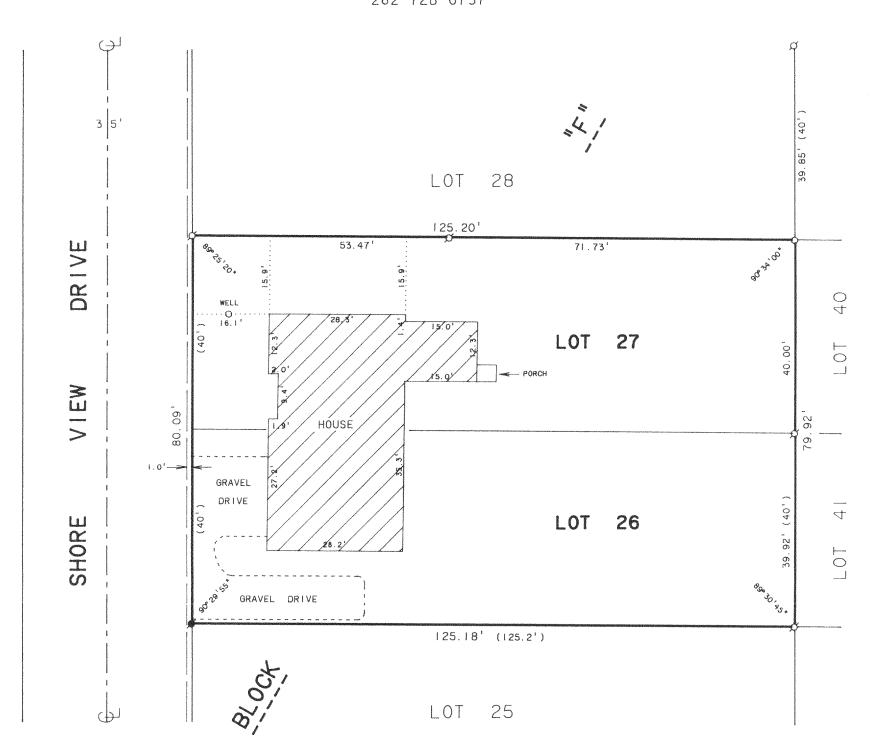

SCALE | "=20"
LEGEND


Ø - IRON PIPE FOUND

■ - IRON ROD FOUND

O -IRON PIPE SET, found 11/30/99

- OVERHEAD UTILITY LINES

()-RECORDED AS

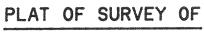

LOTS 26 AND 27. BLOCK "F" OF CISCO BEACH, A SUBDIVISION LOCATED IN TIN.RITE, WALWORTH COUNTY, WISCONSIN.



I HEREBY CERTIFY THAT ! HAVE SURVEYED THE ABOVE DESCRIBED PROPERTY AND THAT THE ABOVE MAP IS A TRUE REPRESENTATION THEREOF AND SHOWS THE SIZE AND LOCATION OF THE PROPERTY, ITS EXTERIOR BOUNDARIES, THE LOCATION OF ALL VISIBLE STRUCTURES AND DIMENSIONS OF ALL PRINCIPAL BUILDINGS THEREON, BOUNDARY FENCES, APPARENT EASEMENTS, ROADWAYS AND VISIBLE ENCROACHMENTS, IF ANY, TO THE BEST OF MY KNOWLEDGE AND BELIEF.

THIS SURVEY IS MADE FOR THE USE OF THE PRESENT OWNERS OF THE PROPERTY, AND ALSO THOSE WHO PURCHASE, MORTGAGE, OR GUARANTEE THE TITLE THERETO WITHIN ONE (1) YEAR FROM DATE HEREOF.

DAVID F. ABELL

WISCONSIN REGISTERED LAND SURVEYOR, S-1596

REVISED AND RECERTIFIED NOVEMBER 30, 1999 ORDERED BY: KEEFE REAL ESTATE

E KEEFE REAL ESTATE
P.O. BOX 460
LAKE GENEVA, WI 53147

June 13, 1991

JOB NUMBER - 91118A

NOTE: THIS IS NOT A CERTIFIED COPY UNLESS SEALED.

ORDERED BY: NEWPORT REALTY

101 BROAD STREET

LAKE GENEVA, WI. 53147

ICI - 198

117-1864