


HAROLD H. KOLB

REGISTERED PROFESSIONAL LAND SURVEYOR
LAKE GENEVA, WISCONSIN

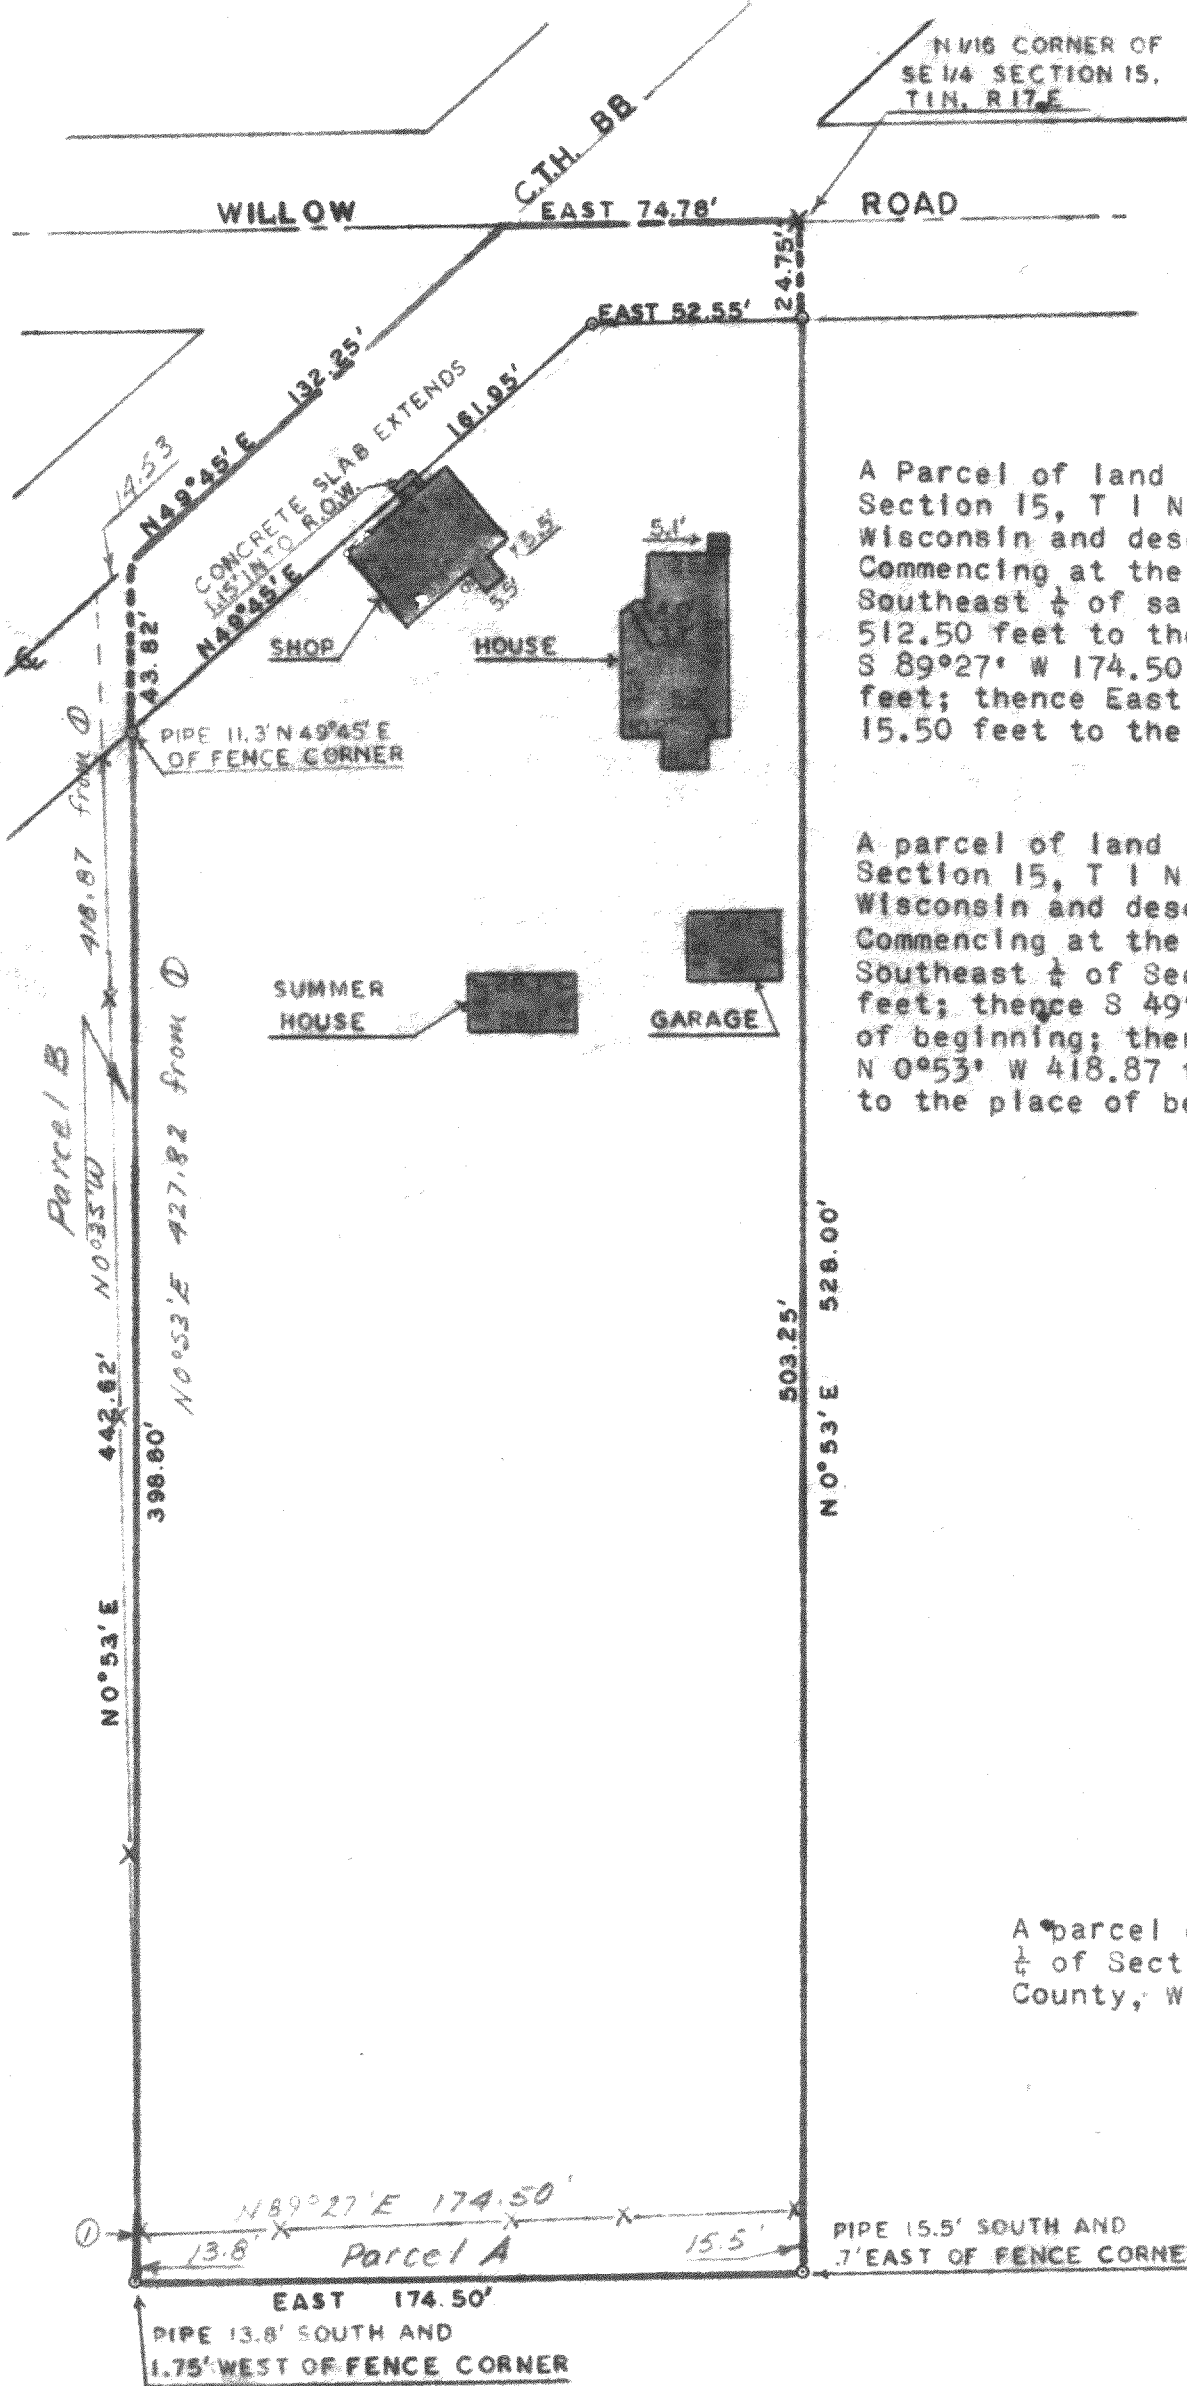

N
SCALE — 1" = 50'
LEGEND
X — IRON PIPE FOUND
O — IRON PIPE PLACED
● — CONCRETE MONUMENT
—X— FENCE

I, HAROLD H. KOLB, DO HEREBY CERTIFY THAT I HAVE SURVEYED THE PROPERTY HEREON DESCRIBED ACCORDING TO THE OFFICIAL RECORDS, AND THAT THE PLAT HEREON IS A CORRECT REPRESENTATION OF THE LOT LINES.

Harold H. Kolb
HAROLD H. KOLB
WISCONSIN REGISTERED LAND SURVEYOR, S-187
DATE March 16, 1967
REVISED: MARCH 30, 1967

L-15-189 - part of
C.S. 1671

117-189