ABERNATHY and ASSOCIATES

Kenneth B. Abernathy Jr.

Wisconsin Registered Land Surveyor

S-1594

W4056 BRAY RD. ELKHORN, WI. 53121

PHONE: (262) 723-4260 (OFFICE)

(262) 723-7209 (FAX)

Email: abernathy@elknet.net

PLAT OF SURVEY

LOTS 13-15 INCLUSIVE AND THE EAST 1/2 OF LOT 16 OF BLOCK "F" OF CISCO BEACH SUBDIVISION, LOCATED IN TOWN 1 NORTH, RANGE 17 EAST, WALWORTH COUNTY, WISCONSIN.

ORDERED BY: JUDY HOWE

COLDWELL BANKER

GENEVA LAKES AREA REALTORS

623 W. MAIN ST.


LAKE GENEVA, WI. 53147

OWNER: SALUDA G. MCNEIL

2730 S. HIGHWAY A1A BOX 96

MELBOURNE, FL. 32951

SUBJECT PROPERTY: W4272 CRESCENT DR

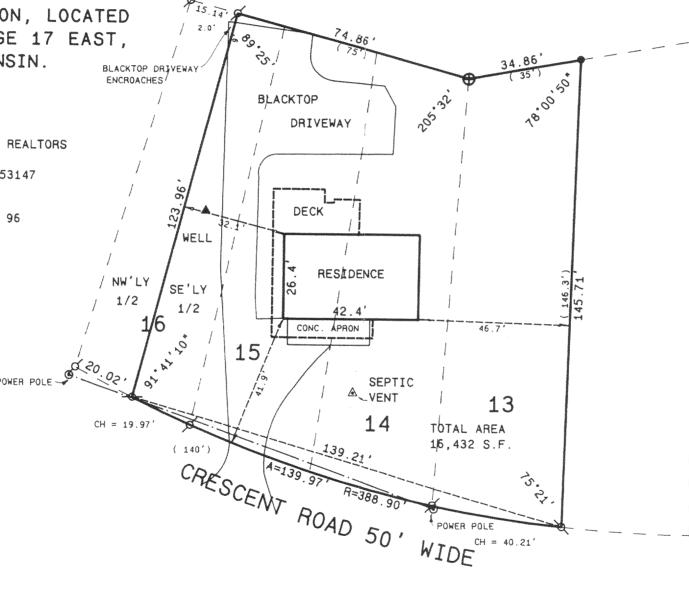



FOUND IRON PIPE

FOUND IRON ROD

FOUND BRASS CAPPED MONUMENT

FOUND CONCRETE MONUMENT

CHISEL CUT IN CONCRETE

SET IRON ROD, 24" LONG, WEIGHING 1.5 LBS./LINEAL FT., 3/4" DIA.

SET IRON ROD, 30" LONG, WEIGHING 4.5 LBS./LINEAL FT., 1-11/16" DIA.

(xx) RECORDED AS DIMENSION

-x-x- EXISTING FENCE



SCALE: 1"=:30 FEET

"I hereby certify that the above described property has been surveyed by me or under my direction and that the above map is a true representation thereof and shows the size and location of the property, its exterior boundaries, the location of all visible structures and dimensions of all principal buildings thereon, boundary fences, apparent easements, roadways and visible encroachments, if any,


"This survey is made for the use of the present owners of the property, and also those who purchase, mortgage, or guarantee the title thereto

KENNETH B. ABERNATHY, JR. WISCONSIN REGISTERED LAND SURVEYOR,

S-1594

Date: 55PT. 15,2000

00.905 Job No.

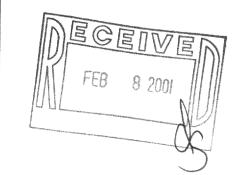

TOI-114