ORDERED BY: JULIE EKMAN W3683 LINWOOD AVE. LAKE GENEVA, WI

PLAT OF SURVEY


J.K. SURVEYING INC. N3705 WILLOWBEND LANE LAKE GENEVA, WI, 53147 262-248-3697

- OF -

LOT 1, BLOCK 5 OF GENEVISTA, LOCATED IN SECTION 10, T.1.N., R.17.E., WALWORTH COUNTY, WISCONSIN.

LINNWOOD AVE.

(50' WIDE)

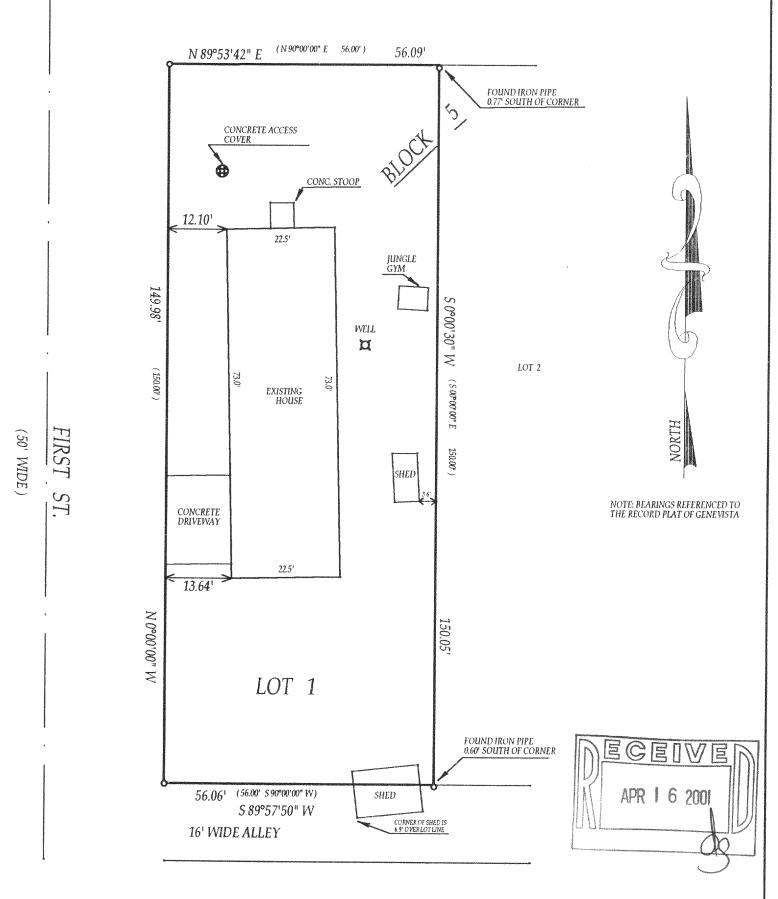

()= recorded as

= found iron bar

= found iron pipe

= set iron pipe

= set iron bar

COMPARE LEGAL DESCRIPTION ABOVE AND DRAWING WITH DEED. FOR BUILDING RESTRICTIONS AND EASEMENTS NOT SHOWN, REFER TO DEED, ABSTRACT SOURCES AND LOCAL MUNICIPAL CODES. NOTIFY THE SURVEYOR IMMEDIATELY OF ANY DISCREPANCY.

SCALE 1'' = 20'

JOB # 01-024

TAXID # 1-17-IGV-16

"I hereby certify that I have surveyed the above described property and that the above map is a true representation thereof and shows the size and location of all visible structures, apparent easements and encroachments

This survey is made for the present owners of the property, and those who purchase, mortgage, or guarantee the title thereto, within one year from the date hereof.

DATED THIS ____5 TH, DAY OF __FEBRUARY 20 ___01 .



JOHN KROTT S - 2258 Wisconsin Registered Land Surveyor (original if signed in red)