



PLAT OF SURVEY

— WORK ORDERED BY —
BARB HIFFMAN
N1715 HILLSIDE
LAKE GENEVA, WI 53147

FARRIS, HANSEN & ASSOCIATES, INC.
ENGINEERING — ARCHITECTURE — SURVEYING
7 RIDGWAY COURT P.O. BOX 437
ELKHORN, WISCONSIN 53121
OFFICE: (262) 723-2098 FAX: (262) 723-5886

REVISIONS


PROJECT NO.	5681
DATE	06-26-01
SHEET NO.	1 OF 1

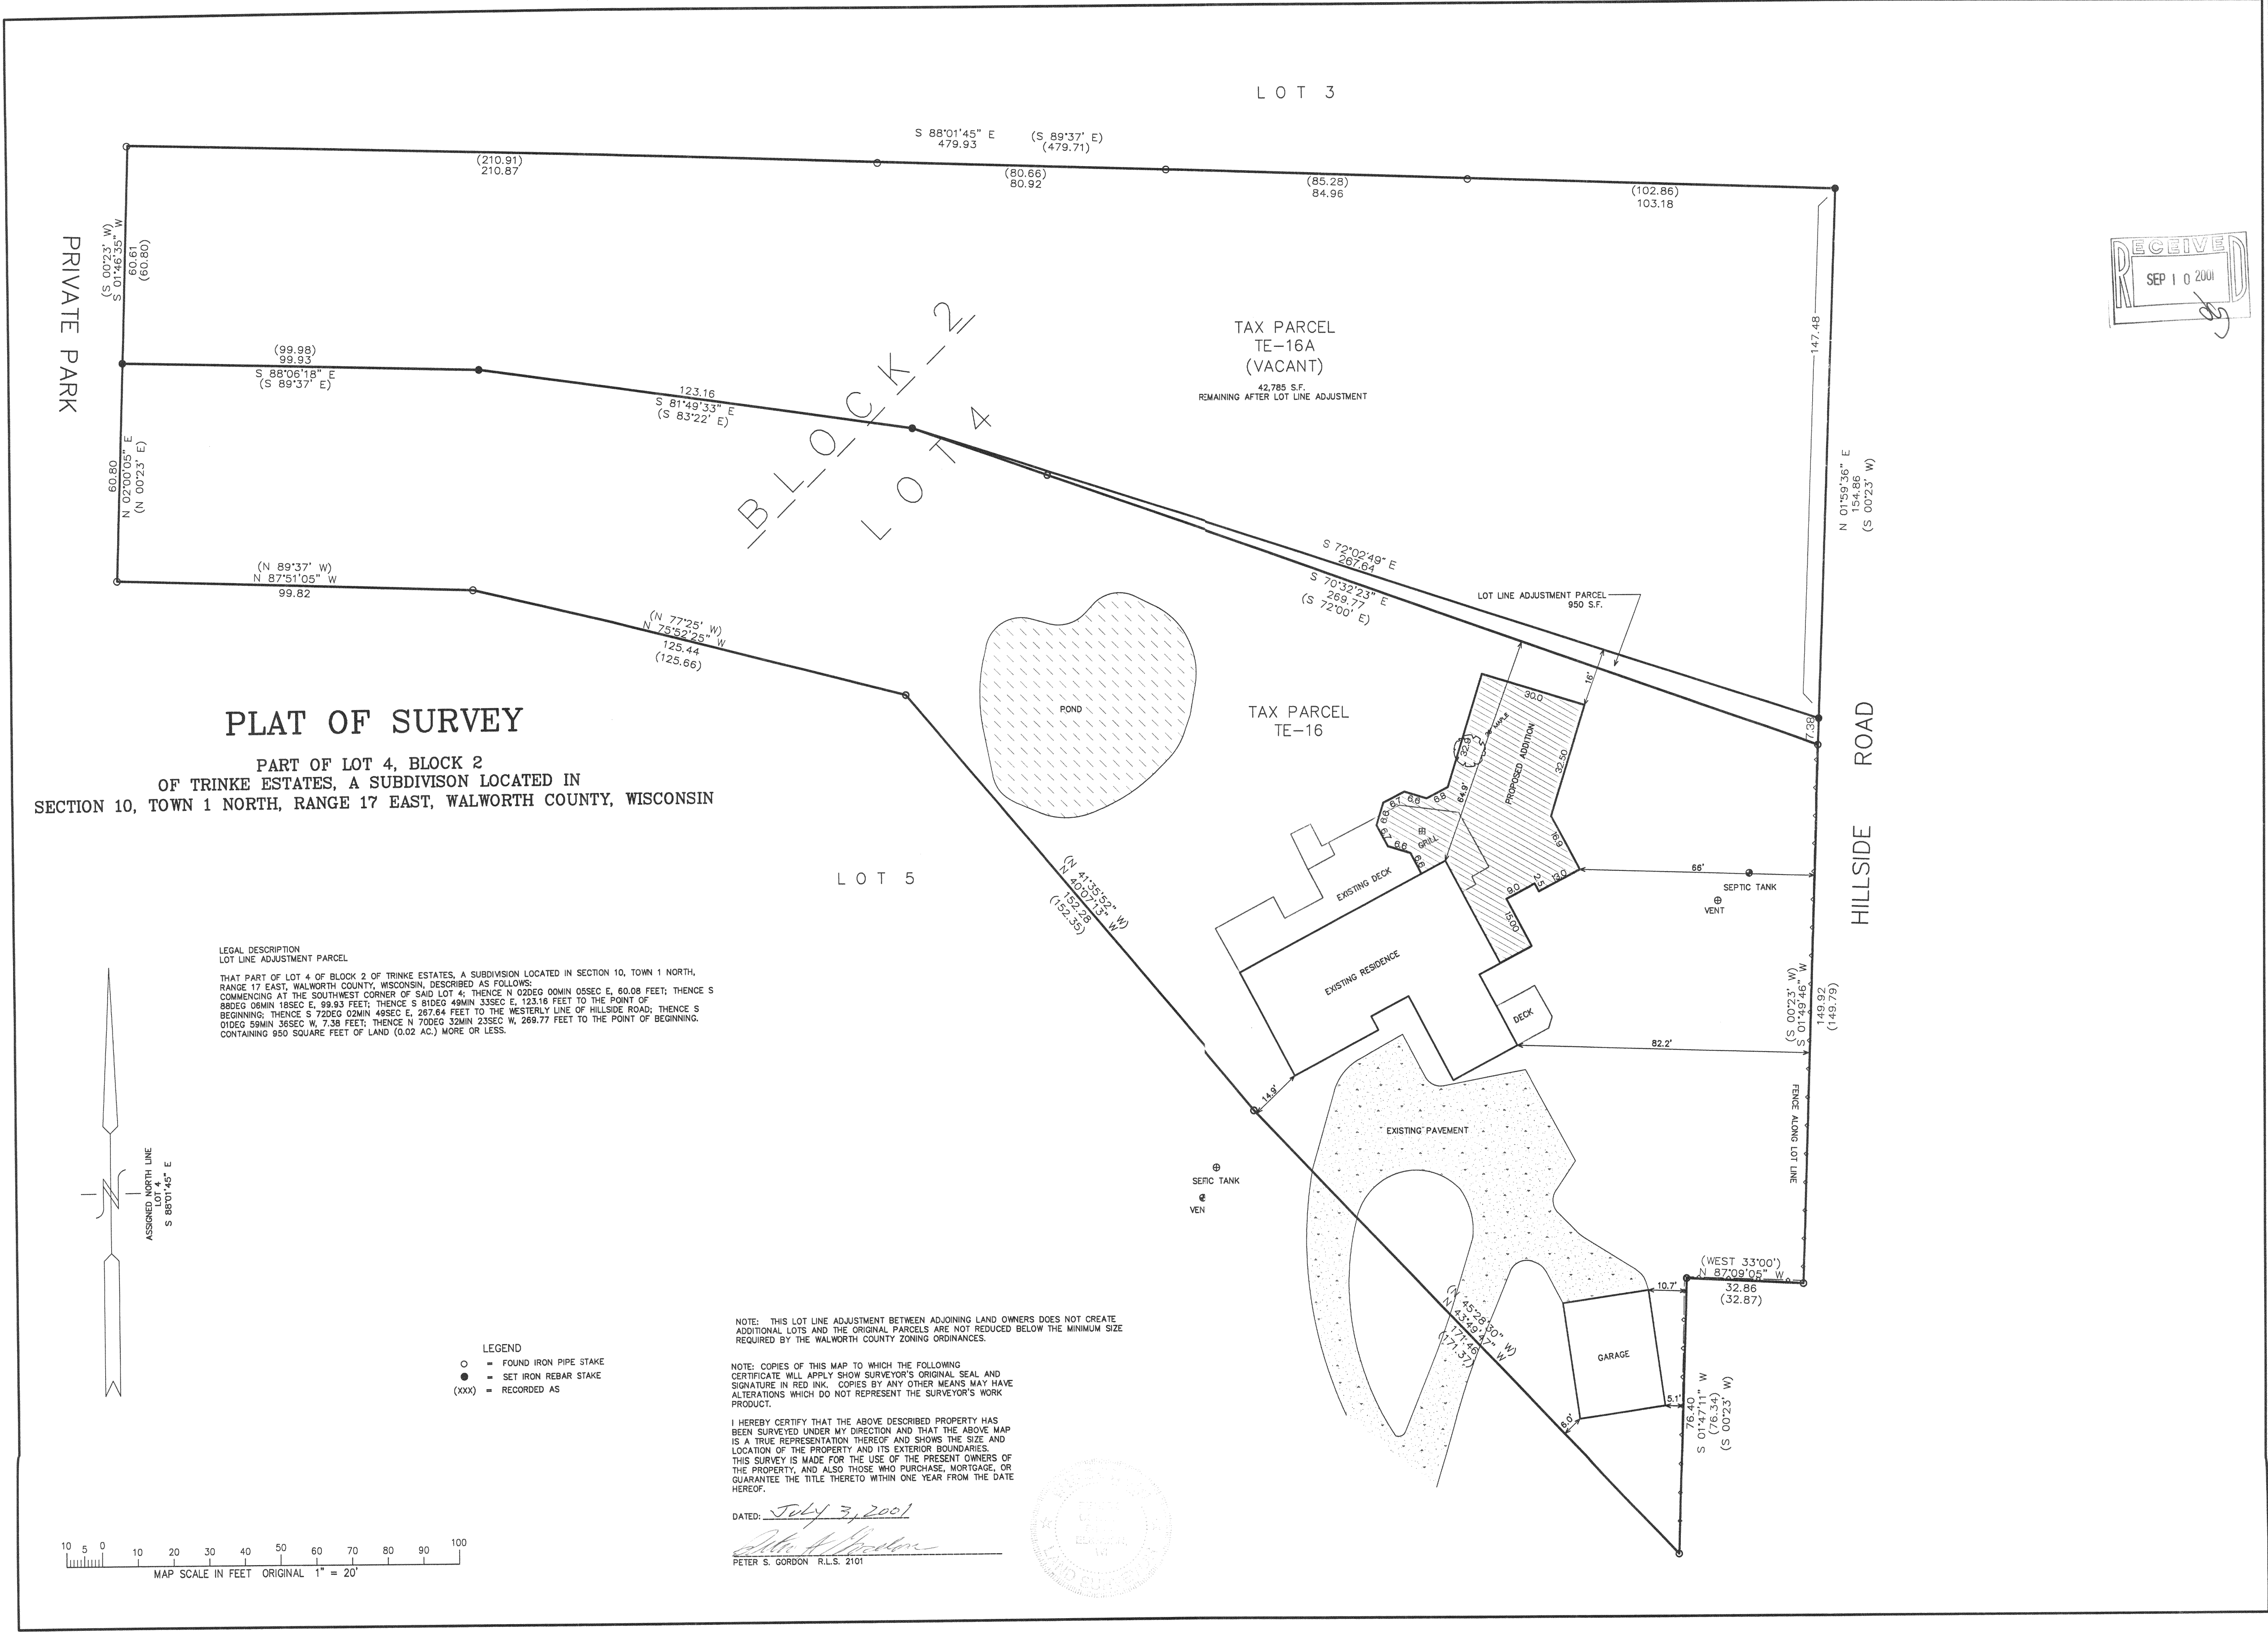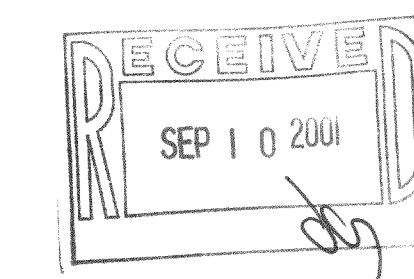

PLAT OF SURVEY

PART OF LOT 4, BLOCK 2
OF TRINKE ESTATES, A SUBDIVISION LOCATED IN
SECTION 10, TOWN 1 NORTH, RANGE 17 EAST, WALWORTH COUNTY, WISCONSIN

LEGAL DESCRIPTION
LOT LINE ADJUSTMENT PARCEL
THAT PART OF LOT 4 OF BLOCK 2 OF TRINKE ESTATES, A SUBDIVISION LOCATED IN SECTION 10, TOWN 1 NORTH, RANGE 17 EAST, WALWORTH COUNTY, WISCONSIN, DESCRIBED AS FOLLOWS:
COMMENCING AT THE SOUTHWEST CORNER OF SAID LOT 4; THENCE N 02°00'05" E, 60.08 FEET; THENCE S 88°06'18" E, 99.93 FEET; THENCE S 81°49'33" E, 123.16 FEET TO THE POINT OF BEGINNING; THENCE S 72°02'49" E, 267.64 FEET TO THE WESTERLY LINE OF HILLSIDE ROAD; THENCE S 01°49'46" W, 149.92 FEET; THENCE N 02°00'05" E, 60.08 FEET TO THE POINT OF BEGINNING.
CONTAINING 950 SQUARE FEET OF LAND (0.02 AC.) MORE OR LESS.

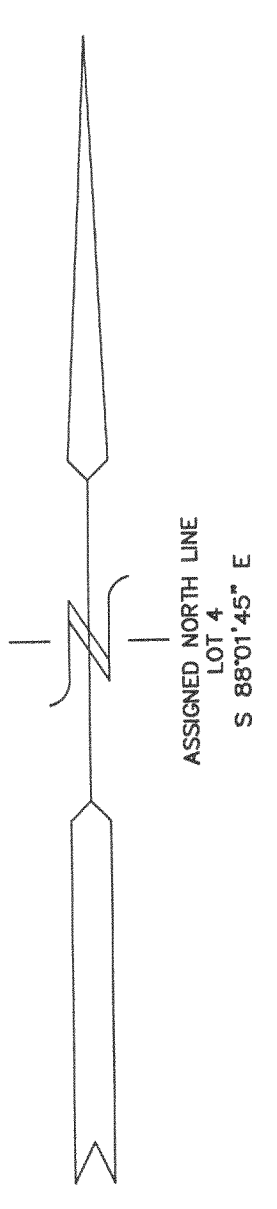

ASSIGNED NORTH LINE
LOT 4, BLOCK 2
S 88°01'45" E



- LEGEND
- = FOUND IRON PIPE STAKE
 - = SET IRON REBAR STAKE
 - (XXX) = RECORDED AS

NOTE: THIS LOT LINE ADJUSTMENT BETWEEN ADJOINING LAND OWNERS DOES NOT CREATE ADDITIONAL LOTS AND THE ORIGINAL PARCELS ARE NOT REDUCED BELOW THE MINIMUM SIZE REQUIRED BY THE WALWORTH COUNTY ZONING ORDINANCES.

NOTE: COPIES OF THIS MAP TO WHICH THE FOLLOWING CERTIFICATE WILL APPLY SHOW SURVEYOR'S ORIGINAL SEAL AND SIGNATURE IN RED INK. COPIES BY ANY OTHER MEANS MAY HAVE ALTERATIONS WHICH DO NOT REPRESENT THE SURVEYOR'S WORK PRODUCT.

I HEREBY CERTIFY THAT THE ABOVE DESCRIBED PROPERTY HAS BEEN SURVEYED UNDER MY DIRECTION AND THAT THE ABOVE MAP IS A TRUE REPRESENTATION THEREOF AND SHOWS THE SIZE AND LOCATION OF THE PROPERTY AND ITS EXTERIOR BOUNDARIES. THIS SURVEY IS MADE FOR THE USE OF THE PRESENT OWNERS OF THE PROPERTY, AND ALSO THOSE WHO PURCHASE, MORTGAGE, OR GUARANTEE THE TITLE THEREIN WITHIN ONE YEAR FROM THE DATE HEREOF.

DATED: July 3, 2001
Peter S. Gordon
PETER S. GORDON R.L.S. 2101

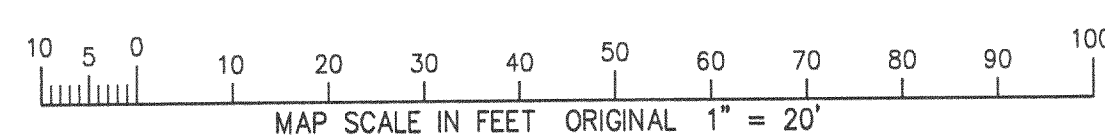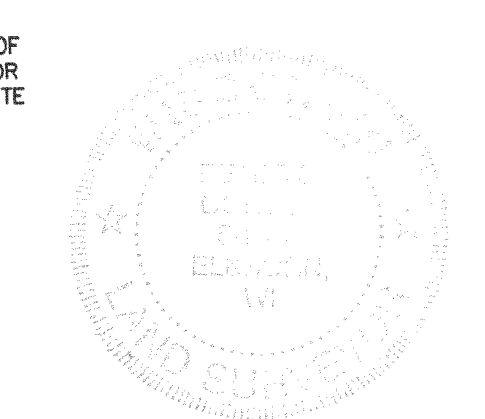

JUL 03 2001

ITE-16A 117-2828