
## PLAT OF SURVEY

- OF -

J.K. SURVEYING INC. N3705 WILLOWBEND LANE LAKE GENEVA, WI, 53147 262-248-3697

LOT C OF C.S.M. #22 AS RECORDED IN THE OFFICE OF THE REGISTER OF DEEDS FOR WALWORTH COUNTY, WISCONSIN ON JULY 6, 1966 IN VOLUME 1 OF CERTIFIED SURVEYS ON PAGE 22 AS DOC. NO. 582707, SAID SURVEY BEING A PART OF LOTS 4 AND 5, S.B. CHAPINS SUBDIVISION AND A PART OF THE NORTHWEST 1/4 OF SECTION 4, TOWN 1 NORTH RANGE 17 EAST, WALWORTH COUNTY, STATE OF WISCONSIN.

ALSO THAT PART OF THE STRIP OF LAND WHICH IS 12 FEET IN WIDTH, AND DESCRIBED AS THE "RIGHT-OF-WAY FOR OWNERS OF LOTS A-C" ON C.S.M NO. 22 AS RECORDED IN THE OFFICE OF THE REGISTER OF DEEDS FOR WALWORTH COUNTY, WISCONSIN ON JULY 6, 1966 IN VOLUME 1 OF C.S.M. PAGE 22 AS DOCUMENT NO. 582707, SAID SURVEY BEING A PART OF LOTS 4 AND 5, S.B. CHAPINS SUBDIVISION AND PART OF THE NORTHWEST 1/4 OF SECTION 4, T1N, R17E, COUNTY OF WALWORTH, STATE OF WISCONSIN WHICH PART BEGINS AT THE SHORE OF LAKE GENEVA AND PROCEEDS ONLY TO THE POINT WERE SAID 12 FOOT STRIP WOULD BE INTERSECTED BY THE NORTH LOT LINE OF LOT A (HEREIN THE "LAKE ACCESS STRIP"). FOR PURPOSES OF THIS INSTRUMENT THE LAKE ACCESS STRIP DOES NOT INCLUDE ANY PORTION OF THE 12 FOOT STRIP "DESIGNATED AS RIGHT-OF-WAY FOR OWNERS OF LOTS A-C" ON C.S.M. NO. 22 LYING NORTH LOT LINE OF LOT A,

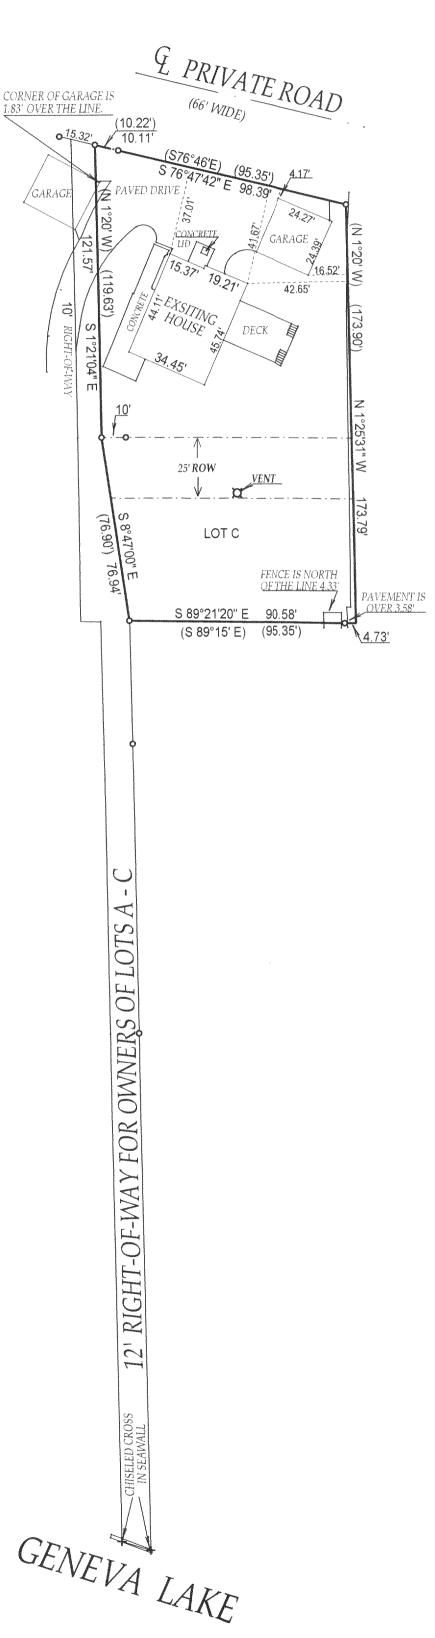


COMPARE LEGAL DESCRIPTION ABOVE AND DRAWING WITH DEED. FOR BUILDING RESTRICTIONS AND EASEMENTS NOT SHOWN, REFER TO DEED, ABSTRACT SOURCES AND LOCAL MUNICIPAL CODES. NOTIFY THE SURVEYOR IMMEDIATELY OF ANY DISCREPANCY.

"I hereby certify that I have surveyed the above described property and that the above map is a true representation thereof and shows the size and location of all visible structures, apparent easements and encroachments if any."

This survey is made for the present owners of the property, and those who purchase, mortgage, or guarentee the title thereto, within one year from the date hereof.

DATED THIS \_\_\_\_\_\_15\_TH, DAY OF JANUARY 20 02

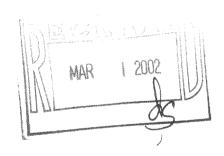



JOHN KROTT S - 2258
Wisconsin Registered Land Surveyor
( original if signed in red )

( )= recorded as

= iron pipe found

= iron pipe set

SCALE 1" = 40'

JOB # 02-011

TAX ID # IA 2200003