


PREPARED FOR : C-21 ZENK REALTY

PLAT OF SURVEY

OF

J.K. SURVEYING INC.
N3705 WILLOWBEND LANE
LAKE GENEVA, WI, 53147
262-248-3697

LOT 53 - 54 OF PARADISE VISTA SUBDIVISION, LOCATED IN SECTION 1,
TOWN 1 NORTH, RANGE 17 EAST, WALWORTH COUNTY, WISCONSIN

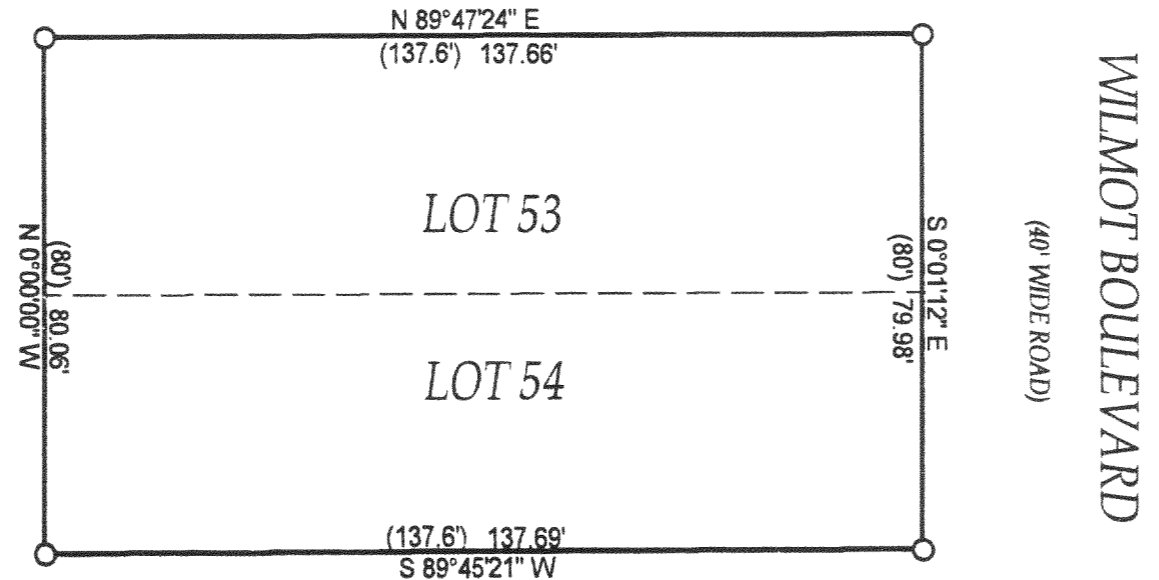

WILMOT BOULEVARD
(40' WIDE ROAD)



- () = recorded as
- = found iron bar
- = found iron pipe
- = set iron pipe
- = set iron bar

SCALE 1" = 20'


JOB# 02-060

TAX KEY # IPV -5A2

COMPARE LEGAL DESCRIPTION ABOVE AND DRAWING WITH DEED. FOR BUILDING RESTRICTIONS AND EASEMENTS NOT SHOWN, REFER TO DEED, ABSTRACT SOURCES AND LOCAL MUNICIPAL CODES. NOTIFY THE SURVEYOR IMMEDIATELY OF ANY DISCREPANCY.

"I hereby certify that I have surveyed the above described property and that the above map is a true representation thereof and shows the size and location of all visible structures, apparent easements and encroachments if any."

This survey is made for the present owners of the property, and those who purchase, mortgage, or guarantee the title thereto, within one year from the date hereof.

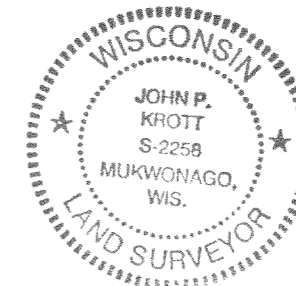

BEARINGS ARE ASSUMED

JOHN KROTT S - 2258
Wisconsin Registered Land Surveyor
(original if signed in red)

DATE FEBRUARY 19, 2002

IPV-SA2 ✓

117-2099

