ABERNATHY and ASSOCIATES

Kenneth B. Abernathy Jr.

Wisconsin Registered Land Surveyor

W4056 BRAY RD. ELKHORN, WI. 53121

PHONE: (262) 723-4260 (OFFICE)

(262) 723-7209 (FAX)

Email: abernathy@elknet.net

PLAT OF SURVEY

S-1594

LOT 3 OF CERTIFIED SURVEY MAP NO. 3321 VOL. 19 P. 20-24 DOC. NO. 470772.

OWNER: HAROLD SMITH 3600 W. LAKE AVE. GLENVIEW. IL. 60025


EASEMENT LEGAL DESCRIPTION

AN EASEMENT FOR INGRESS AND EGRESS OVER LOT 2 OF CERTIFIED SURVEY MAP NO. 3321 FOR THE BENEFIT OF LOT 3 OF CERTIFIED SURVEY MAP NO. 3321, LOCATED IN THE NORTHEAST 1/4 AND THE SOUTHWEST 1/4 OF THE SOUTHWEST 1/4 OF SECTION 11, TOWN 1 NORTH, RANGE 17 EAST, TOWN OF LINN, WALWORTH COUNTY, DESCRIBED AS FOLLOWS: BEGIN AT THE NORTHWEST CORNER OF SAID LOT 2; THENCE EAST ALONG THE NORTH LINE OF SAID LOT 2, 66 FEET; THENCE S 38'14'53" W 127.99 FEET TO A FOUND IRON ROD IN THE WESTERLY LINE OF SAID LOT 2, THENCE N 7°30'00" E ALONG SAID WESTERLY LINE 101.38 FEET TO THE POINT OF BEGINNING.

> INGRESS AND EGRESS EASEMENT

OVER LOT 2 FOR BENEFIT OF LOT 3


LOT 1

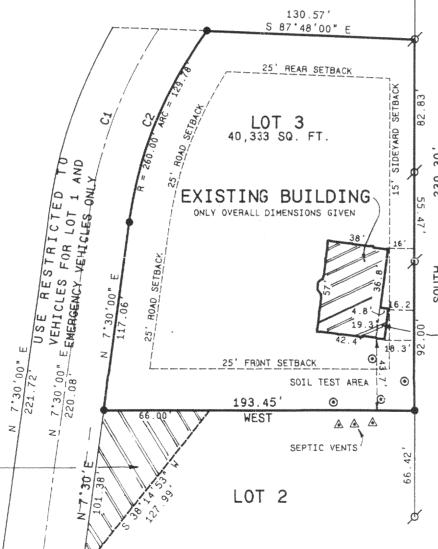

RADIUS CHORD LENGTH CHORD BEARING 25'17'07" 285 00 N 20"08'33" E 124.76 28'36'00" 260.00 128.44 N 21 48 00 E

EMERGENCY VEHICLE EASEMENT

LOTS 2 AND 3 HAVE AN EASEMENT FOR INGRESS AND EGRESS FOR EMERGENCY VEHICLES OVER THE EXISTING BLACKTOP DRIVEWAY LOCATED ON LOT 1 AND SHOWN ON PLAT OF SURVEY FILE NO. 117-1751 IN THE WALWORTH COUNTY SURVEYOR'S RECORDS. THIS BLACKTOP DRIVEWAY WOULD REPRESENT A TURN AROUND AREA FOR LARGE VEHICLES

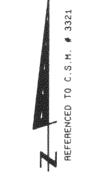

SCALE 1" = 60 FEET

Legend O FOUND IRON PIPE FOUND IRON ROD

FOUND BRASS CAPPED MONUMENT FOUND CONCRETE MONUMENT

CHISEL CUT IN CONCRETE

SET IRON ROD, 24" LONG, WEIGHING

1.5 LBS./LINEAL FT., 3/8" DIA. SET IRON ROD, 30" LONG, WEIGHING 4.5 LBS./LINEAL FT., 1-11/16" DIA.

RECORDED AS DIMENSION

EXISTING FENCE





SCALE: 1"= 60 FEET

"I hereby certify that the above described property has been surveyed by me or under my direction and that the above map is a true representation thereof and shows the size and location of the property. its exterior boundaries, the location of all visible structures and dimensions of all principal buildings thereon, boundary fences, apparent easements, roadways and visible encroachments, if any."

This survey is made for the use of the present owners of the property, and also those who purchase, mortgage, or guarantee the title thereto within one year from date hereof

KENNETH B, ABERNATHY, JR. WISCONSIN REGISTERED LAND SURVEYOR.

S-1594

Job No. 94.419 Date: July 23, 200

REVISED TO SHOW AS BUILT LOCATION 12/3/01

5' x 15'

BASEMENT

OUTSIDE STAIRCASE TO

15' MIN. SIDEYARD SETBACK