ABERNATHY and ASSOCIATES

Kenneth B. Abernathy Jr.

Wisconsin Registered Land Surveyor

S-1594

W4056 BRAY RD. ELKHORN, WI. 53121

PHONE: (262) 723-4260 (OFFICE)/

(262) 723-7209 (FAX)


Email: abernathy@elknet.net

## PLAT OF SURVEY

LOTS 80 THRU 83 INCLUSIVE OF BLOCK 4 OF LAKEVIEW PARK SUBDIVISION, ACCORDING TO THE RECORD PLAT THEREOF, TOWN OF LINN, WALWORTH COUNTY, WISCONSIN.

PARK DRIVE

HICKORY DRIVE

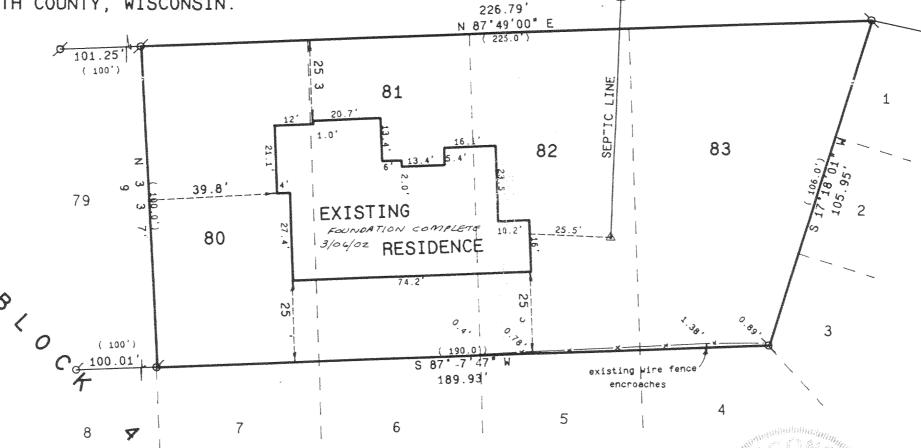

ORDERED BY: SCHAUDER BUILDING, INC.
4115 HIGHWAY 51 NORTH
JANESVILLE, WISCONSIN
53545-9674

WOOD STAKES HAVE BEEN PLACED AT BUILDING CORNERS, BUILDER IS TO VERIFY DIMENSIONS WHICH HAVE BEEN ROUNDED TO THE NEAREST TENTH OF A FOOT TO INSURE PROPER PLAN INTERPRETATION AND CONTACT THIS OFFICE IMMEDIATELY IF ANY DISCREPANCY EXISTS.

THIS SURVEY RETRACES A PREVIOUS PLAT OF SURVEY PREPARED BY JEFFERY KIMPS, RLS NO. S-2436 AND DATED 10/11/01, A COPY OF WHICH WAS PROVIDED BY THE BUILDER AND OWNER TO ASSIST WITH THE PREPARATION OF THIS PLAT.

REVISED 3/6/02 AS BUILT"

KENNETH B.

ABERNATHY, JR



FOUND INON PIPE

FOUND IRON ROD

FOUND BRASS CAPPED MONUMENT

# FOUND CONCRETE MONUMENT

+ CHISEL CUT IN CONCRETE


SET IRON ROD, 24" LONG, WEIGHING 1.5 LBS./LINEAL FT., 3/4" DIA.

SET IRON ROD, 30" LONG, WEIGHING
 4.5 LBS./LINEAL FT., 1-31/16" DIA.

(xx)

RECORDED AS DIMENSION

EXISTING FENCE

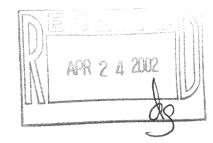

SCALE: 1"= 30 FEET

"I hereby certify that the above described property has been surveyed by me or under my direction and that the above map is a true representation thereof and shows the size and location of the property, its exterior boundaries, the location of all visible structures and dimensions of all principal buildings thereon, boundary fences, apparent easements, roadways and visible encroachments, if any."

"This survey is made for the use of the present owners of the property, and also those who purchase, mortgage, or guarantee the title thereto within one year from date hereof."

KENNETH B. ABERNATHY, JR.
WISCONSIN REGISTERED LAND SURVEYOR,
S-1594

Date: Dec. 14, 2001 Job No. 01.1203

PRODUCTS 093

ILUP-265 117-2114