
## HAROLD H. KOLB

REGISTERED PROFESSIONAL LAND SURVEYOR LAKE GENEVA, WISCONSIN

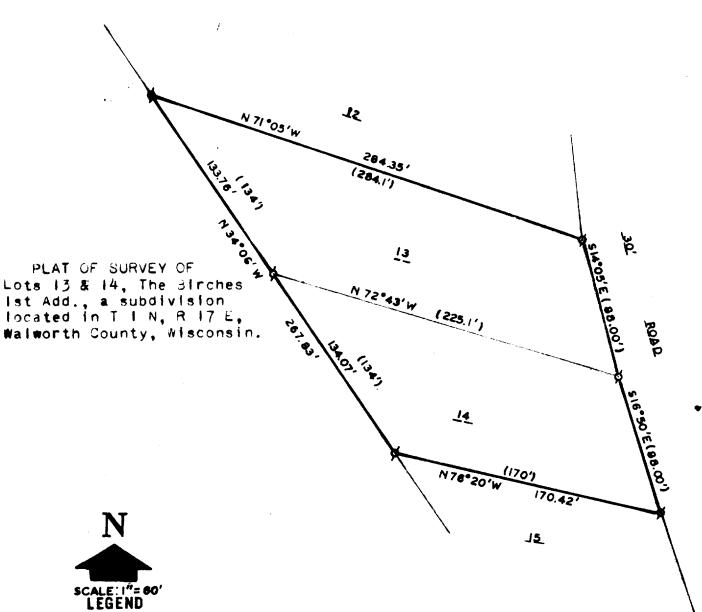

Ø - IRON PIPE FOUND

O - IRON PIPE PLACED

● - concrete Monument found

X - SPIKE

() - AS PLATTED

I, HAROLD H. KOLB, DO HEREBY CERTIFY THAT I HAVE SURVEYED THE PROPERTY HEREON DESCRIBED ACCORDING TO THE OFFICIAL RECORDS, AND THAT THE PLAT HEREON IS A CORRECT REPRESENTATION OF THE LOT LINES.

Harold N. Kolk

HAROLD H. KOLB

WISCONSIN REGISTERED LAND SURVEYOR, S-187

DATE <u>January 23, 1968</u>

117-214

IBA1-77A