
7 ANDERSTAPPEN SURVEYING, INC. 217 W. Judd Street Woodstock, Illinois 60098 (815) 337-8310

## PLAT OF SURVEY

Lots 1 and 2 in Shorehaven Subdivision, being a Subdivision of part of Section 18, Township 1 North, Range 17 East, in Linn Township, Walworth County, Wisconsin

## **GENEVA**

## LAKE

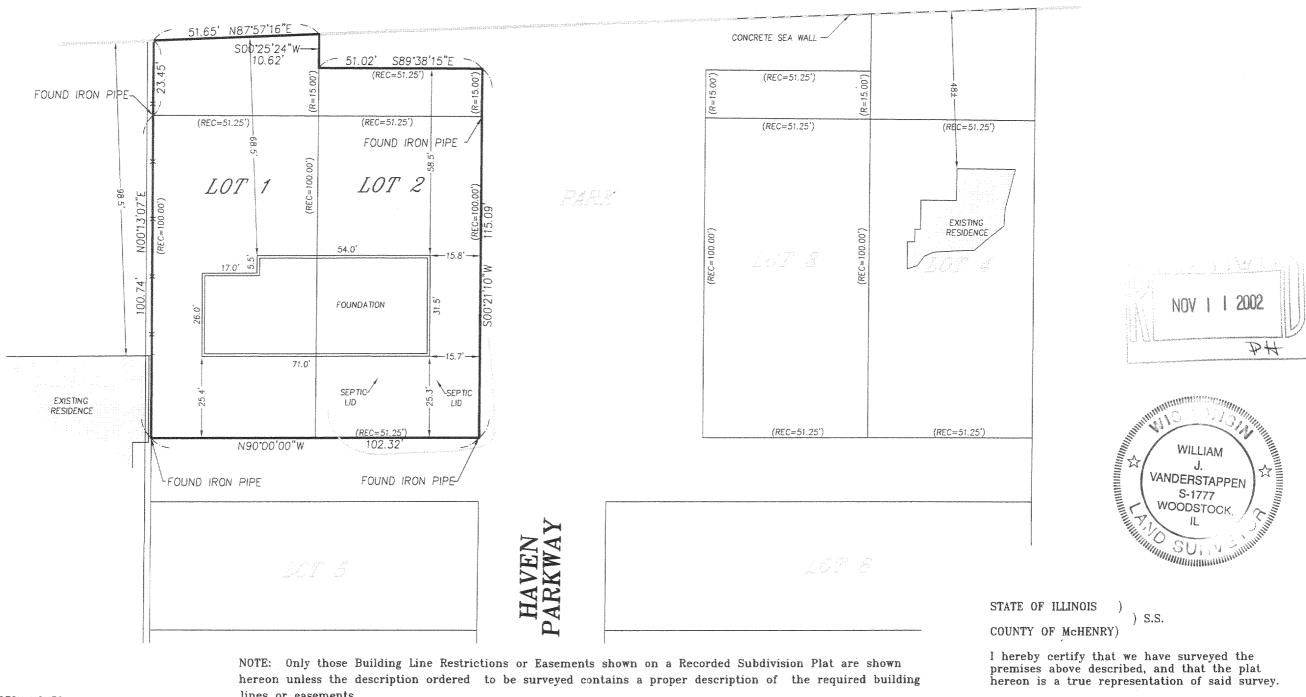

CLIENT: SOUTH HAMPTON HOMES

DRAWN BY: APG CHK'ED BY: WJV SCALE: 1"=30' SEC. 18 T. 1 R. 17 E.

P.I.N .: LINN TWP - WALWORTH COUNTY

JOB NO.: 000742 I.D. FND BK. PG. ALL DISTANCES SHOWN IN FEET AND DECIMAL PARTS THEREOF CORRECTED TO 68° F. lines or easements.

- \* No distance should be assumed by scaling.
- \* No underground improvements have been located unless shown and noted.
- \* No representation as to ownership, use, or possession should be hereon implied.
- \* This Survey and Plat of Survey are void without original embossed or colored seal and signature affixed.

Compare your description and site markings with this plat and AT ONCE report any discrepancies.

Dated at Woodstock,

McHenry County, Illinois 12/14, A.D., 2000.

VANDERSTAPPEN SURVEYING, INC.

Wisconsin Professional Land Surveyor, No. 1777-008