


AMBIT LAND SURVEYING
P. O. BOX 42
Bassett, WI. 53101


PLAT OF SURVEY OF

PHONE 262-537-4874
FAX 262-537-4221

Lot 19 and the South 34 feet of Lot 18, Block 8 of LAKE GENEVA TERRACE, being a subdivision of the West Half of the Northwest Quarter of Section 15, Township 1 North, Range 17 East of the 4th Principal Meridian, Town of Linn, County of Walworth and State of Wisconsin.

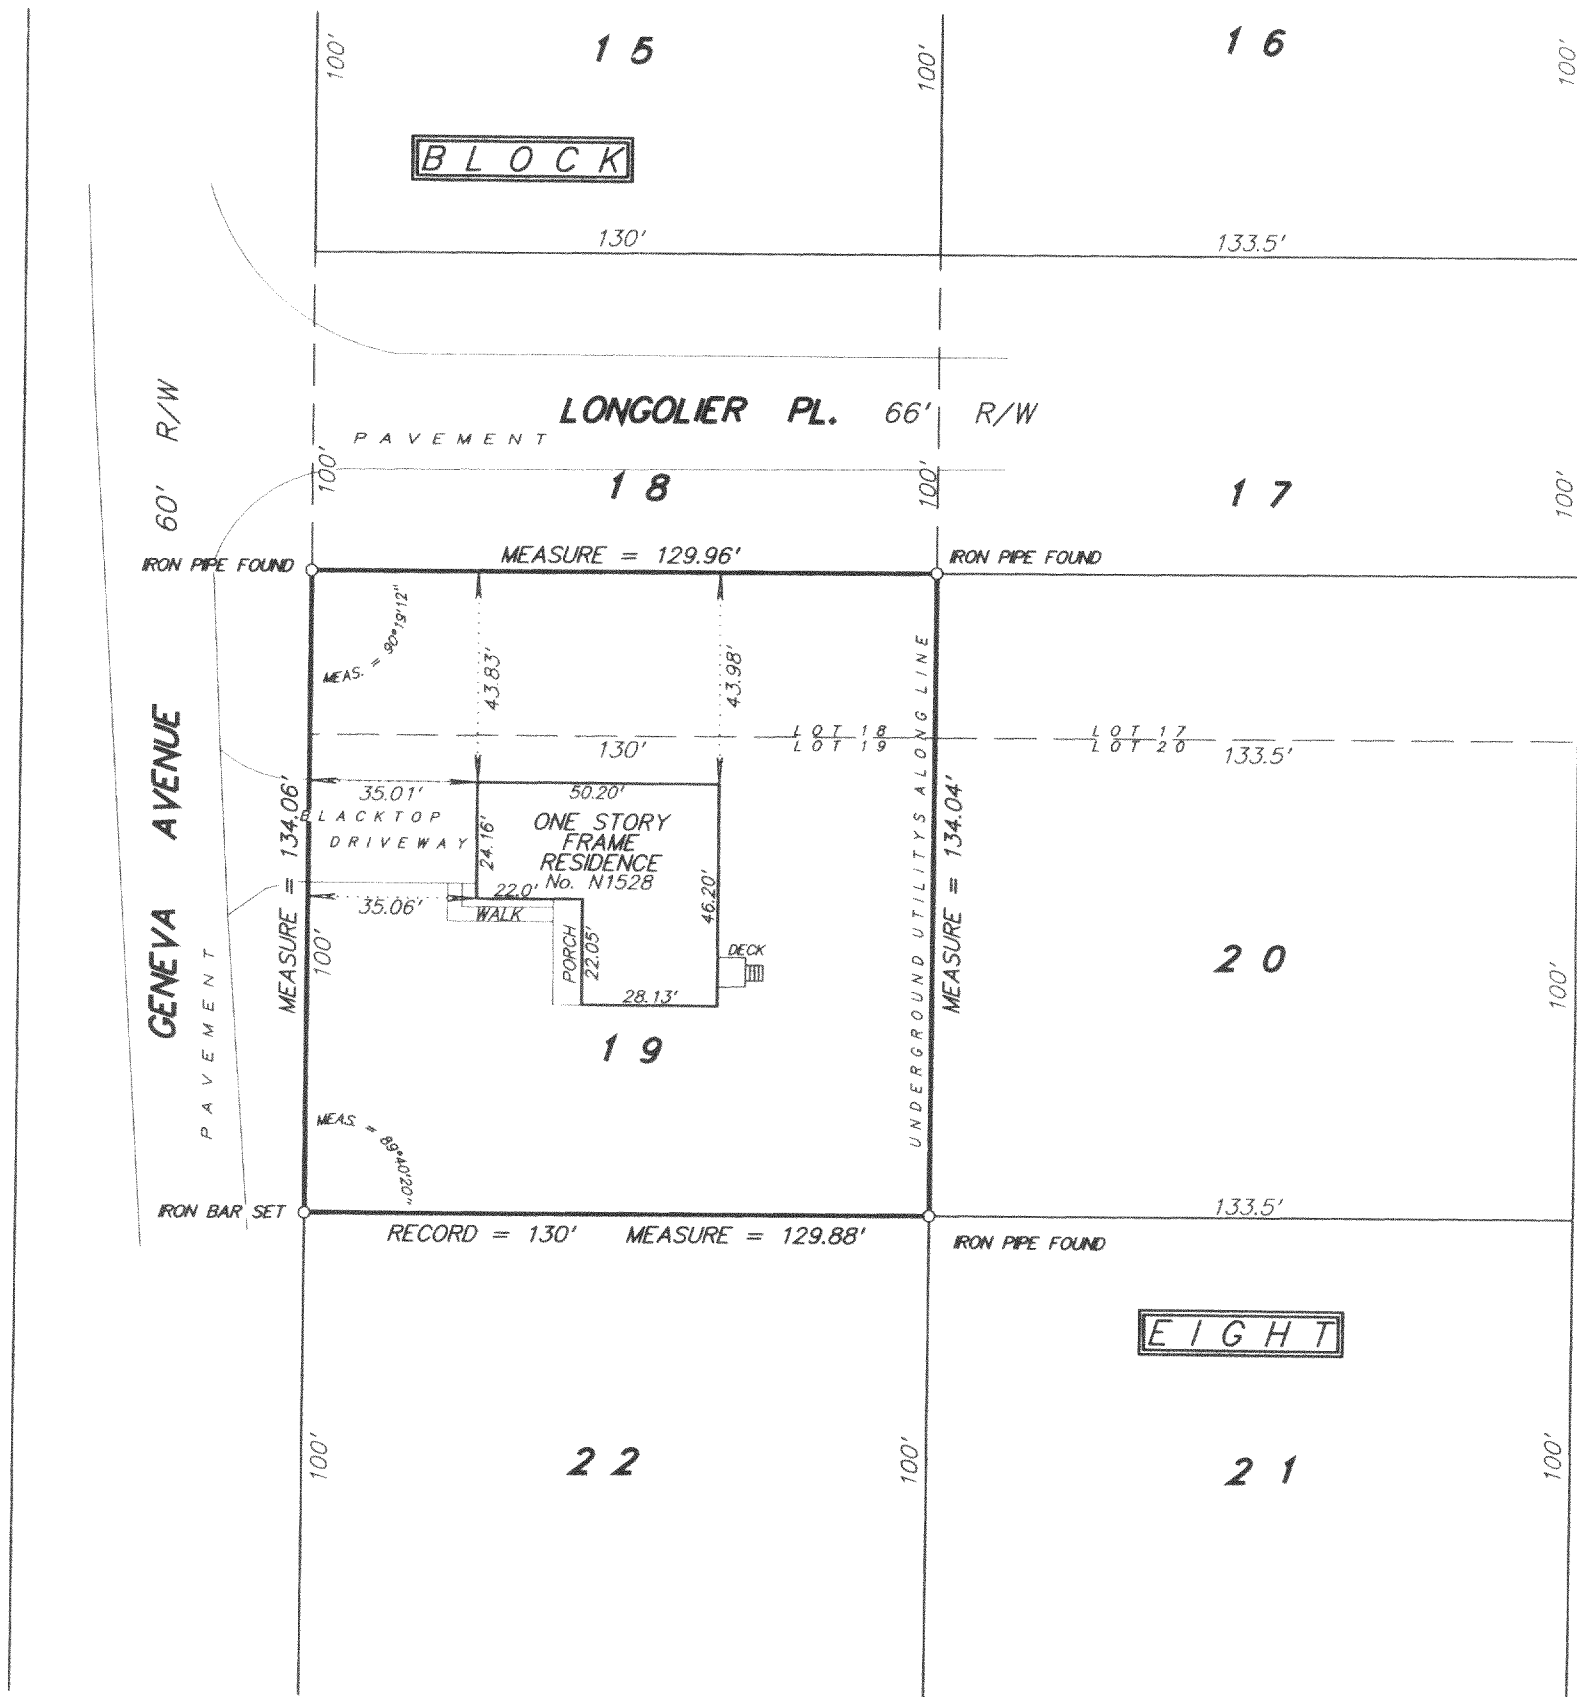

SCALE 1 inch = 40 feet
ORDERED BY A. Pierce / A. R. Pierce & Associates
JOB NO. 02250

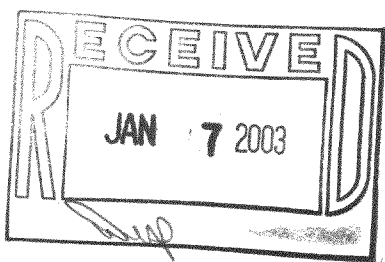

I hereby certify that I have surveyed the above described property and the above plot is a true representation thereof and shows the size and location of the property, its exterior boundaries, the location and dimensions of all visible structures thereon, boundary fences, apparent easements and roadways and visible encroachments, if any.

This survey is made for the exclusive use of the present owners of the property, and also those who purchase, mortgage, or guarantee the title thereto within one year from the date hereof.

Dated at Bassett, Wisconsin this 27 day of September 2002.

Mark A. Bolender

Mark A. Bolender
Wisconsin Registered Land Surveyor S - 1784