
MARY ANN GERNAND REMAX GENEVA REALTY 101 BROAD ST. LAKE GENEVA, WI 53147

PLAT OF SURVEY

J.K. SURVEYING INC. N3705 WILLOWBEND LANE LAKE GENEVA, WI, 53147 262-248-3697

- OF -

LOT 13 GENEVA OAKS A SUBDIVISION LOCATED IN GOV'T. LOT 3, THE NW 1/4 OF SECTION 4 , T.1.N. , R.17.E. WALWORTH COUNTY, WISCONSIN.

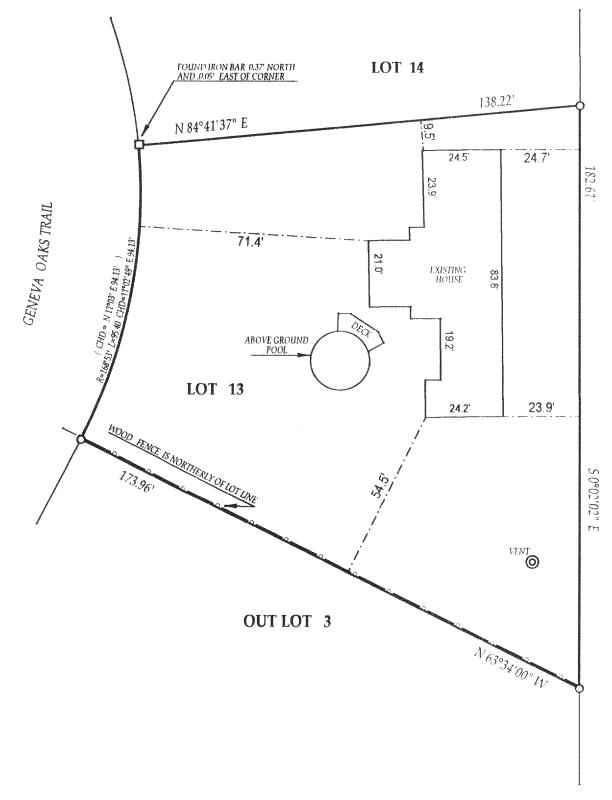



= found iron bar

= found iron pipe

= set iron pipe

= set iron bar

SCALE 1" = 30'

JOB # 03-101

-TAXID-#-03-101-

IGO-13



COMPARE LEGAL DESCRIPTION ABOVE AND DRAWING WITH DEED, FOR BUILDING RESTRICTIONS AND EASEMENTS NOT SHOWN, REFER TO DEED, ABSTRACT SOURCES AND LOCAL MUNICIPAL CODES. NOTIFY THE SURVEYOR IMMEDIATELY OF ANY DISCREPANCY.

"I hereby certify that I have surveyed the above described property and that the above map is a true representation thereof and shows the size and location of all visible structures, apparent easements and encroachments if any."

This survey is made for the present owners of the property, and those who purchase, mortgage, or guarantee the title thereto, within one year from the date hereof.

DATED THIS ____ 11 __TH, DAY OF __MARCH_ 20 __ 03 _.



John Glado

JOHN KROTT S - 2258 Wisconsin Registered Land Surveyor (original if signed in red)