


HAROLD H. KOLB

REGISTERED PROFESSIONAL LAND SURVEYOR
LAKE GENEVA, WISCONSIN

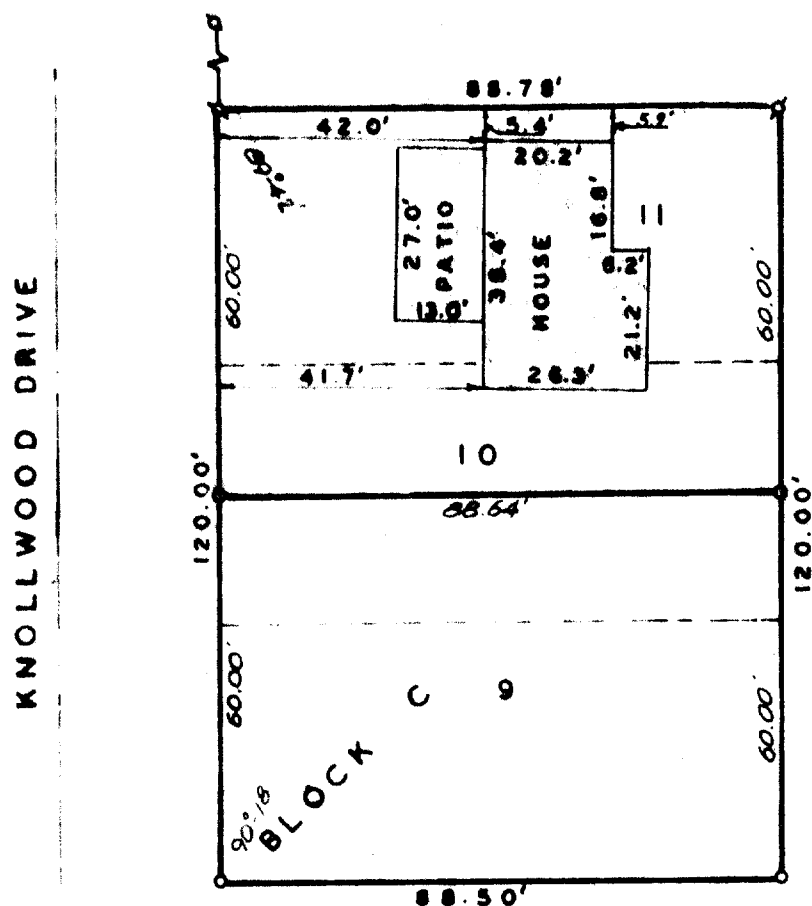

N

SCALE 1"=30'

LEGEND

- ⌵ - IRON PIPE FOUND
- - IRON ROD PLACED
- - CONCRETE MONUMENT
- ✕ - SPIKE



PLAT OF SURVEY OF

Lots 9, 10 and 11, Block C, Cisco Beach
Subdivision, T 1 N, R 17 E, Walworth
County, Wisconsin.

I, HAROLD H. KOLB, DO HEREBY CERTIFY THAT I HAVE
SURVEYED THE PROPERTY HEREON DESCRIBED ACCORDING
TO THE OFFICIAL RECORDS, AND THAT THE PLAT HEREON
IS A CORRECT REPRESENTATION OF THE LOT LINES, and the
principle lines of the buildings thereon.

Harold H. Kolb

HAROLD H. KOLB

WISCONSIN REGISTERED LAND SURVEYOR, S-187

DATE April 28, 1969

Revised - Mar. 3, 1971

117-227