


ABELL
SURVEYING & MAPPING

1140 SEQUOIA STREET • DELAVAN, WISCONSIN 53115
262-728-6737

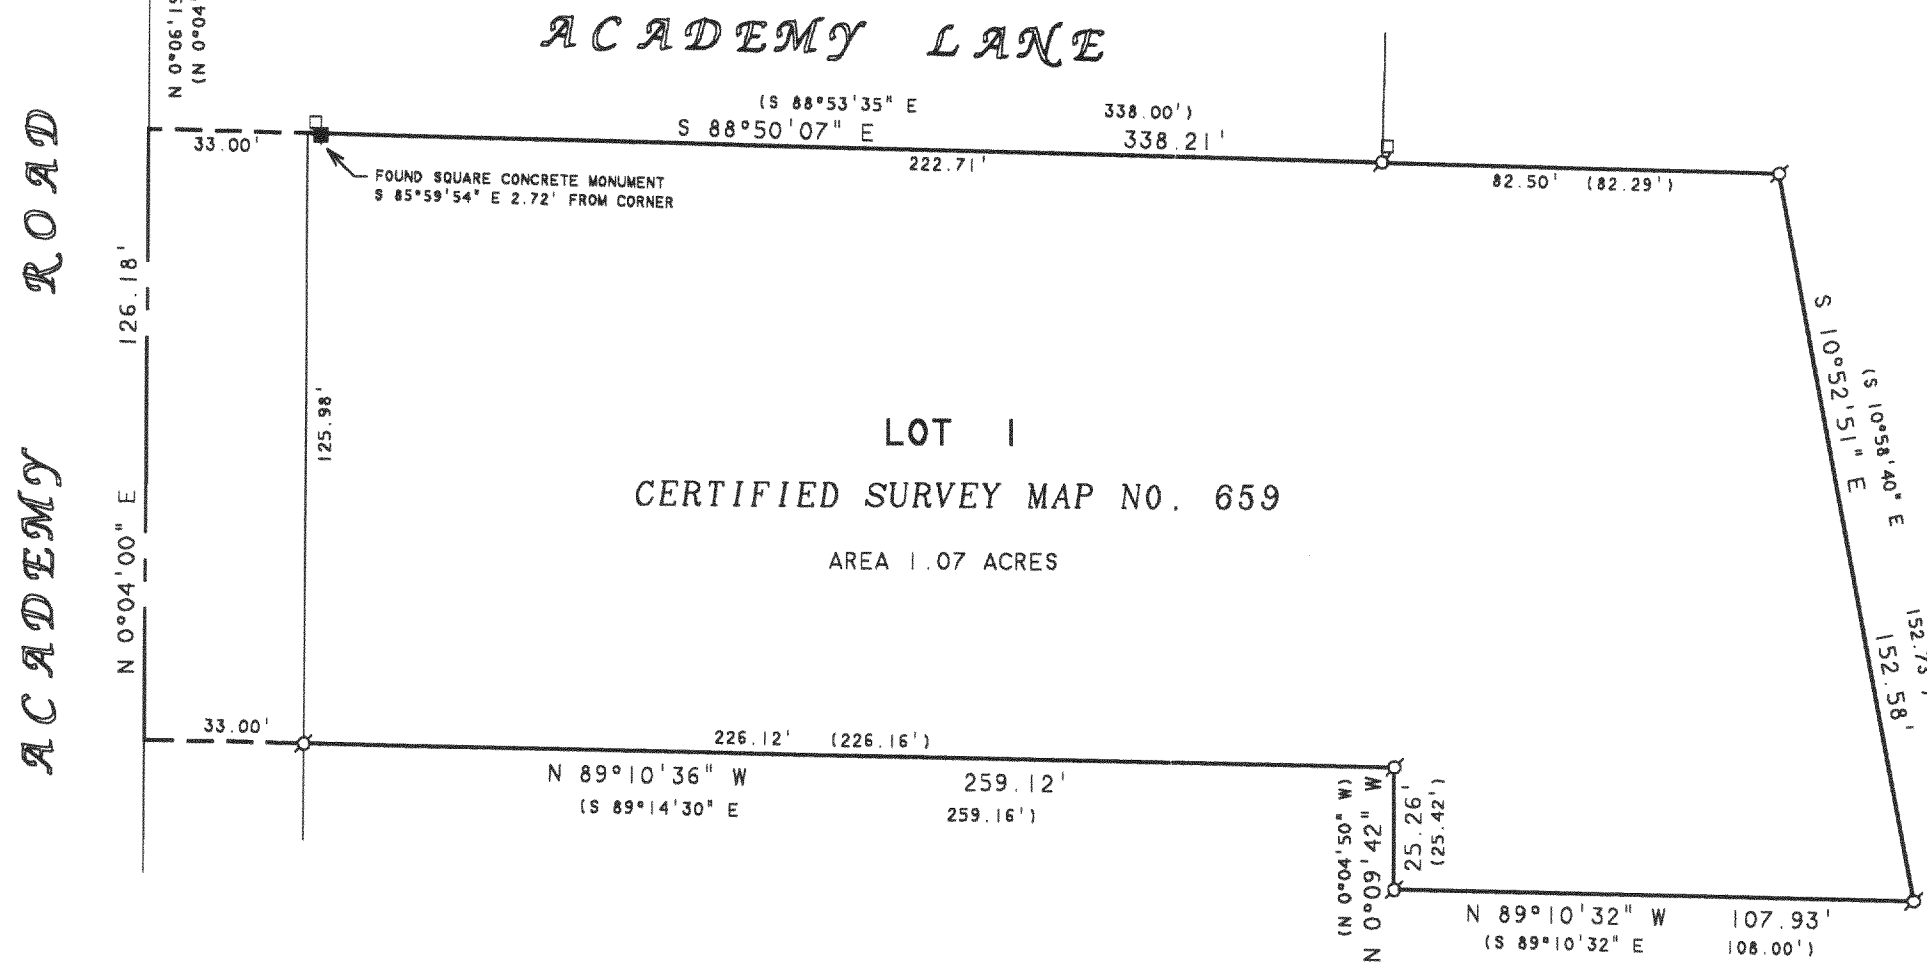


NOTE: BEARINGS ARE REFERENCED TO
CERTIFIED SURVEY MAP NO. 659.

PLAT OF SURVEY OF

LOT 1, CERTIFIED SURVEY MAP NO. 659, LOCATED IN THE
NORTHEAST 1/4 OF THE SOUTHEAST 1/4 OF SECTION 18,
T18N, R17E, WALWORTH COUNTY, WISCONSIN.

ORDERED BY: RE/MAX GENEVA REALTY, LTD.
101 BROAD STREET
LAKE GENEVA, WI 53147

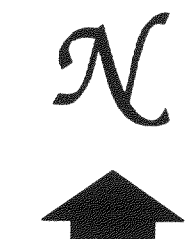

SCALE 1"=40'

LEGEND

- - IRON PIPE FOUND
- - CONCRETE MONUMENT FOUND
- - UTILITY PED
- () - RECORDED AS

RECERTIFIED: JULY 11, 2003
ORDERED BY: MIKE MALINOWSKI
GUARDIAN SECURITY
3300 W. 127th STREET
BLUE ISLAND, IL 60406

I HEREBY CERTIFY THAT I HAVE SURVEYED THE ABOVE DESCRIBED PROPERTY AND THAT THE
ABOVE MAP IS A TRUE REPRESENTATION THEREOF AND SHOWS THE SIZE AND LOCATION OF
THE PROPERTY, ITS EXTERIOR BOUNDARIES, THE LOCATION OF ALL VISIBLE STRUCTURES
AND DIMENSIONS OF ALL PRINCIPAL BUILDINGS THEREON, BOUNDARY FENCES, APPARENT
EASEMENTS, ROADWAYS AND VISIBLE ENCROACHMENTS, IF ANY, TO THE BEST OF MY
KNOWLEDGE AND BELIEF.


THIS SURVEY IS MADE FOR THE USE OF THE PRESENT OWNERS OF THE PROPERTY, AND ALSO
THOSE WHO PURCHASE, MORTGAGE, OR GUARANTEE THE TITLE THERETO WITHIN ONE (1) YEAR
FROM DATE HEREON.

David F. Abell

DAVID F. ABELL
WISCONSIN REGISTERED LAND SURVEYOR, S-1596

May 2, 2001

DATE: May 2, 2001 JOB NUMBER - 01040A
NOTE: THIS IS NOT A CERTIFIED COPY UNLESS SEALED.

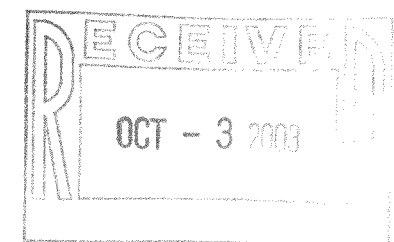

✓ IA659-1

117-2351