

PLAT OF SURVEY

OF
LOT 80 LAKE GENEVA BEACH A SUBDIVISION LOCATED IN SECTION 11
TOWN 1 NORTH, RANGE 17 EAST TOWN OF LINN WALWORTH COUNTY, WISCONSIN

J.K. SURVEYING INC.
N3705 WILLOWBEND LANE
LAKE GENEVA, WI, 53147
262-248-3697

LOT 81

S 89°05'57" W 112.24' (112.5)

LOT 79

LOT 80

LOT 77

S 89°05'57" W 112.21' (112.5)

BASIS OF BEARING "MAGNETIC NORTH"


COMPARE LEGAL DESCRIPTION ABOVE AND DRAWING WITH DEED, FOR BUILDING RESTRICTIONS AND EASEMENTS NOT SHOWN, REFER TO DEED, ABSTRACT SOURCES AND LOCAL MUNICIPAL CODES. NOTIFY THE SURVEYOR IMMEDIATELY OF ANY DISCREPANCY.

"I hereby certify that I have surveyed the above described property and that the above map is a true representation thereof and shows the size and location of all visible structures, apparent easements and encroachments if any."

This survey is made for the present owners of the property, and those who purchase, mortgage, or guarantee the title thereto, within one year from the date hereof.

WEST BEACH DRIVE (25' WIDE)

NORTH

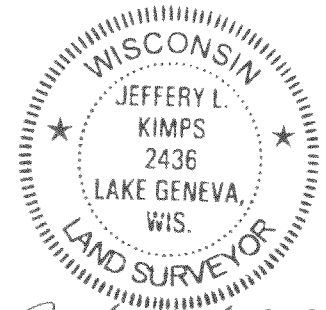

JEFFERY L. KIMPS S-2436-008
Wisconsin Registered Land Surveyor

DATE: JULY 17, 2003

117-2361

OCT - 3 2003

DR

FOUND IRON PIPE
S 29°31'48" E
1.00' FROM CORNER
UTILITY POLE AT CORNER

- () = recorded as
- = found iron bar
- = found iron pipe
- = set iron pipe
- = set iron bar

SCALE 1" = 20'

JOB# 03-434

TAX KEY # ILGB 00072