


PREPARED FOR :
EDWARD GRAMS
315 MARION AVE
AURORA, IL. 60505

PLAT OF SURVEY

-OF-


J.K. SURVEYING INC.
N3705 WILLOWBEND LANE
LAKE GENEVA, WI, 53147
262-248-3697

LOTS 12-14 BLOCK 4 MAPLE HILLS "A" A SUBDIVISION LOCATED IN
T1N, R17E, WALWORTH COUNTY, WISCONSIN.

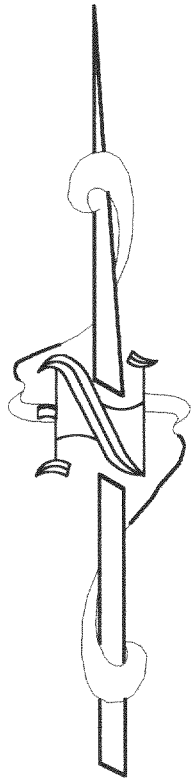

(50' WIDE)

C.L. MAPLE HILLS DRIVE

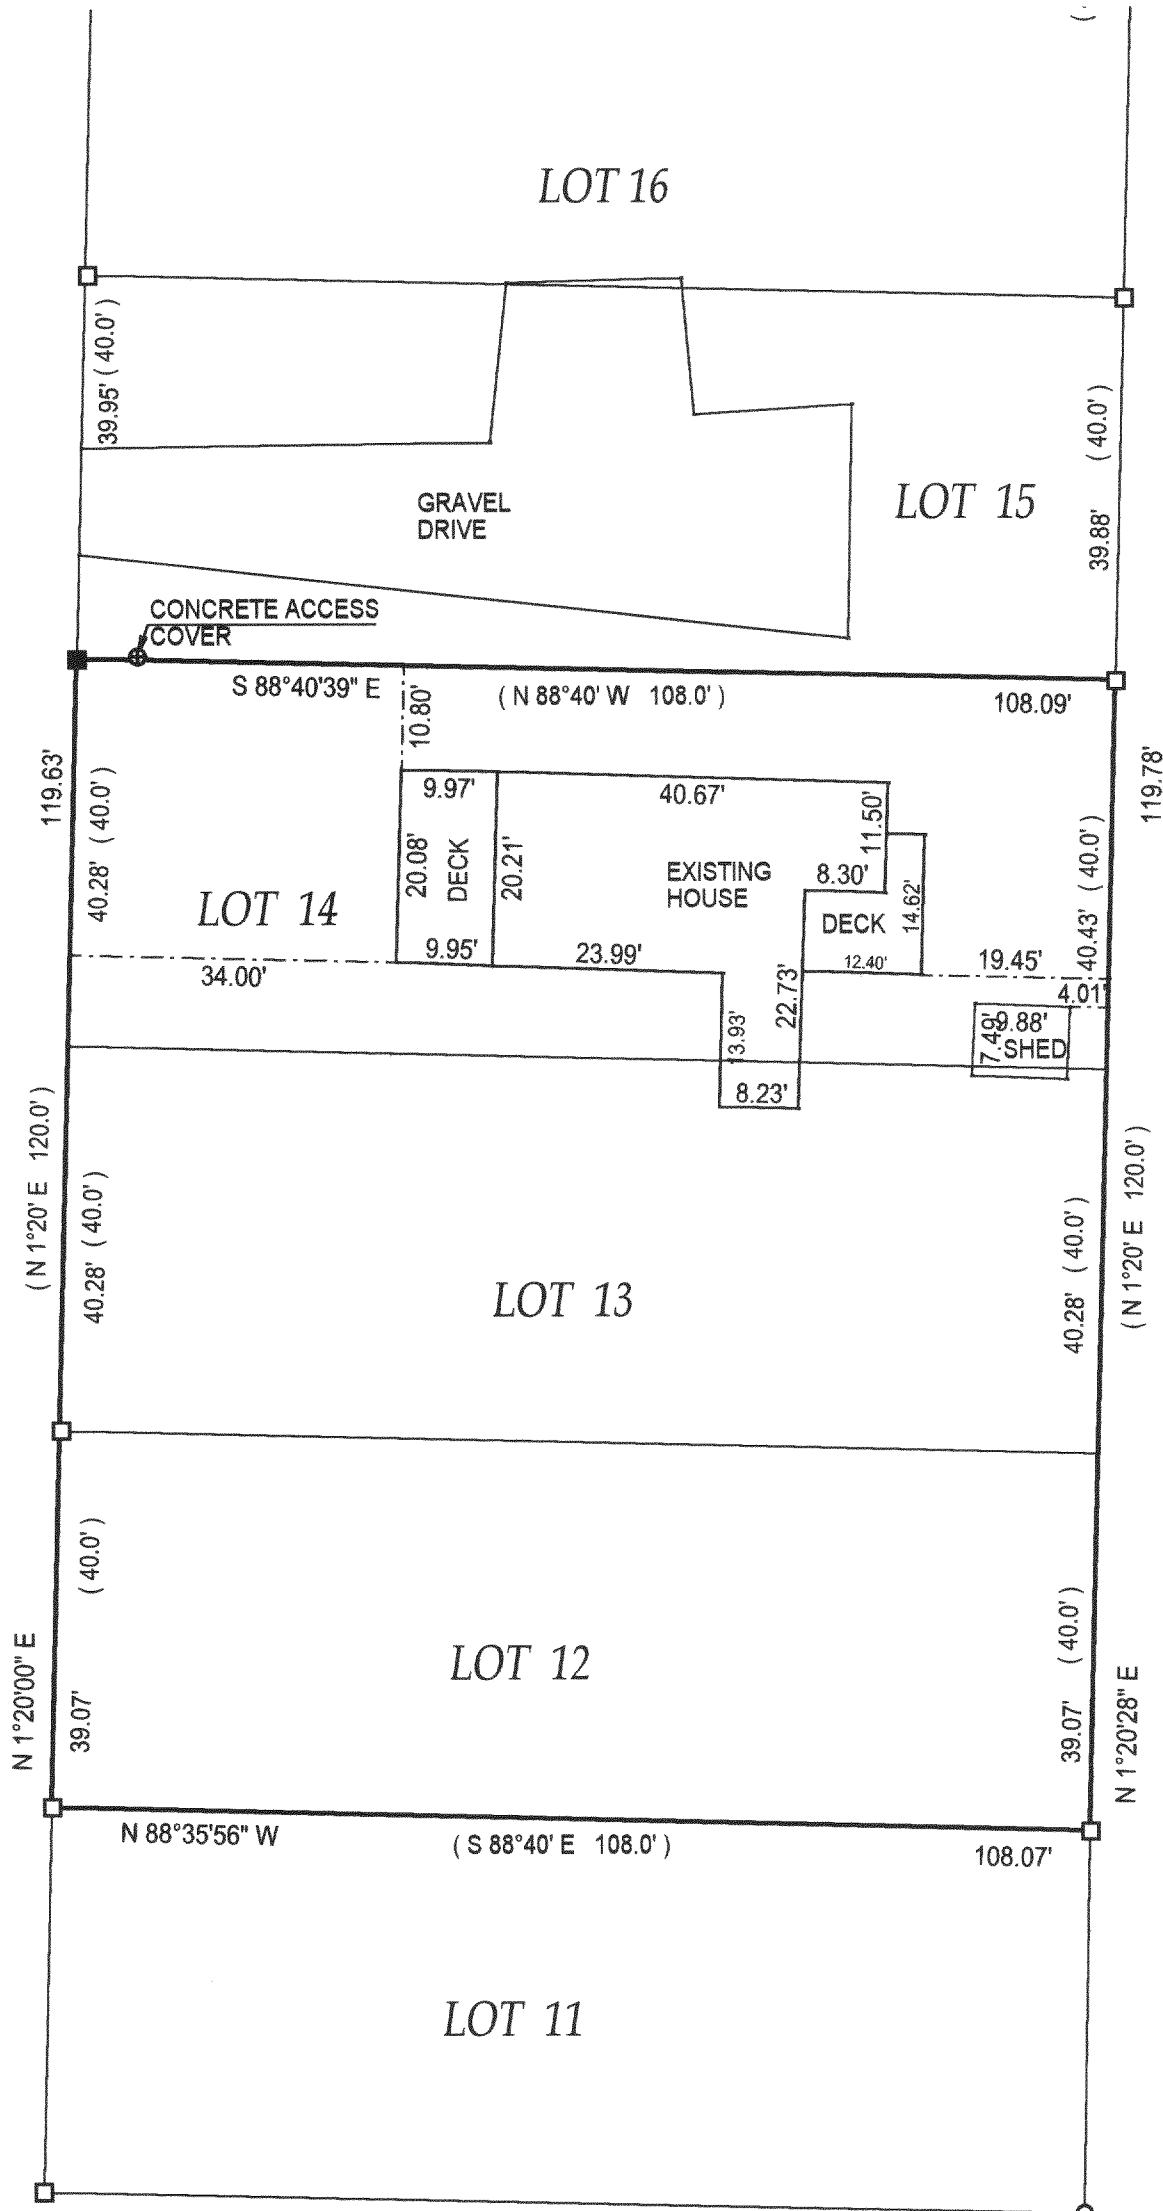

OCT - 3 2003

() = recorded as

□ = found iron bar

○ = found iron pipe

● = set iron pipe

■ = set iron bar

SCALE 1" = 20

JOB # 03-164A


TAX ID # IMH 00072

COMPARE LEGAL DESCRIPTION ABOVE AND DRAWING WITH DEED. FOR BUILDING RESTRICTIONS AND EASEMENTS NOT SHOWN, REFER TO DEED, ABSTRACT SOURCES AND LOCAL MUNICIPAL CODES. NOTIFY THE SURVEYOR IMMEDIATELY OF ANY DISCREPANCY.

"I hereby certify that the above described property was surveyed under my supervision and that the above map is a true representation thereof and shows the size and location of all visible structures, apparent easements and encroachments if any."

This survey is made for the present owners of the property, and those who purchase, mortgage, or guarantee the title thereto, within one year from the date hereof.

DATED THE 18 TH, DAY OF APRIL 2003

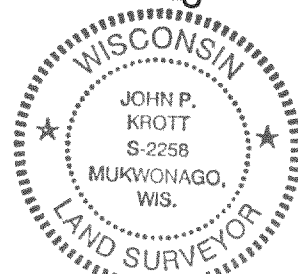

JOHN KROTT S - 2258
Wisconsin Registered Land Surveyor
(original if signed in red)

117-2364