

PLAT OF SURVEY

PREPARED FOR :  
LYNDA TRESTER  
COLDWELL BANKER PRIMUS REALTY  
226 BROAD STREET  
LAKE GENEVA, WI. 53147

-OF-

J.K. SURVEYING INC.  
N3705 WILLOWBEND LANE  
LAKE GENEVA, WI, 53147  
262-248-3697

LOT 14 AND 15 IN ROBINSON'S SUBDIVISION OF PART OF SECTION 11  
AND 14, IN T1N, R17E, SAME AS BEING IN THE TOWN OF LINN, IN THE  
COUNTY OF WALWORTH AND THE STATE OF WISCONSIN.

LOT 16

LOT 15

LOT 14

LOT 13

FENCE CORNER IS .08' SOUTH  
AND 1.29' EAST OF CORNER


FENCE CORNER IS .67' SOUTH  
AND 2.08' WEST OF CORNER

(50' WIDE)

C.L. ELM STREET

FENCE CORNER IS .16' EAST  
AND .26' NORTH OF CORNER

FENCE CORNER IS .28' SOUTH  
AND 1.07' EAST OF CORNER

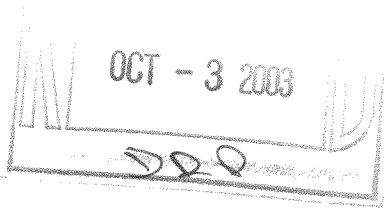

- ( ) = recorded as
- = found iron bar
- = found iron pipe
- = set iron pipe
- = set iron bar

COMPARE LEGAL DESCRIPTION ABOVE AND DRAWING WITH DEED. FOR BUILDING RESTRICTIONS AND  
EASEMENTS NOT SHOWN, REFER TO DEED, ABSTRACT SOURCES AND LOCAL MUNICIPAL CODES. NOTIFY  
THE SURVEYOR IMMEDIATELY OF ANY DISCREPANCY.

"I hereby certify that the above described property was surveyed under my  
supervision and that the above map is a true representation thereof and  
shows the size and location of all visible structures, apparent easements  
and encroachments if any."  
This survey is made for the present owners of the property, and those who  
purchase, mortgage, or guarantee the title thereto, within one year from  
the date hereof.



*John P. Krott*

JOHN KROTT S - 2258  
Wisconsin Registered Land Surveyor  
( original if signed in red )

SCALE 1" = 20'  
JOB # 03-392

TAX ID # IRB1 00012

DATED THE 2 ND, DAY OF JULY 2003

117-2367