


PLAT OF SURVEY

LOCATED IN SECTION 18, TOWN 1 NORTH, RANGE 17 EAST,
WALWORTH COUNTY, WISCONSIN

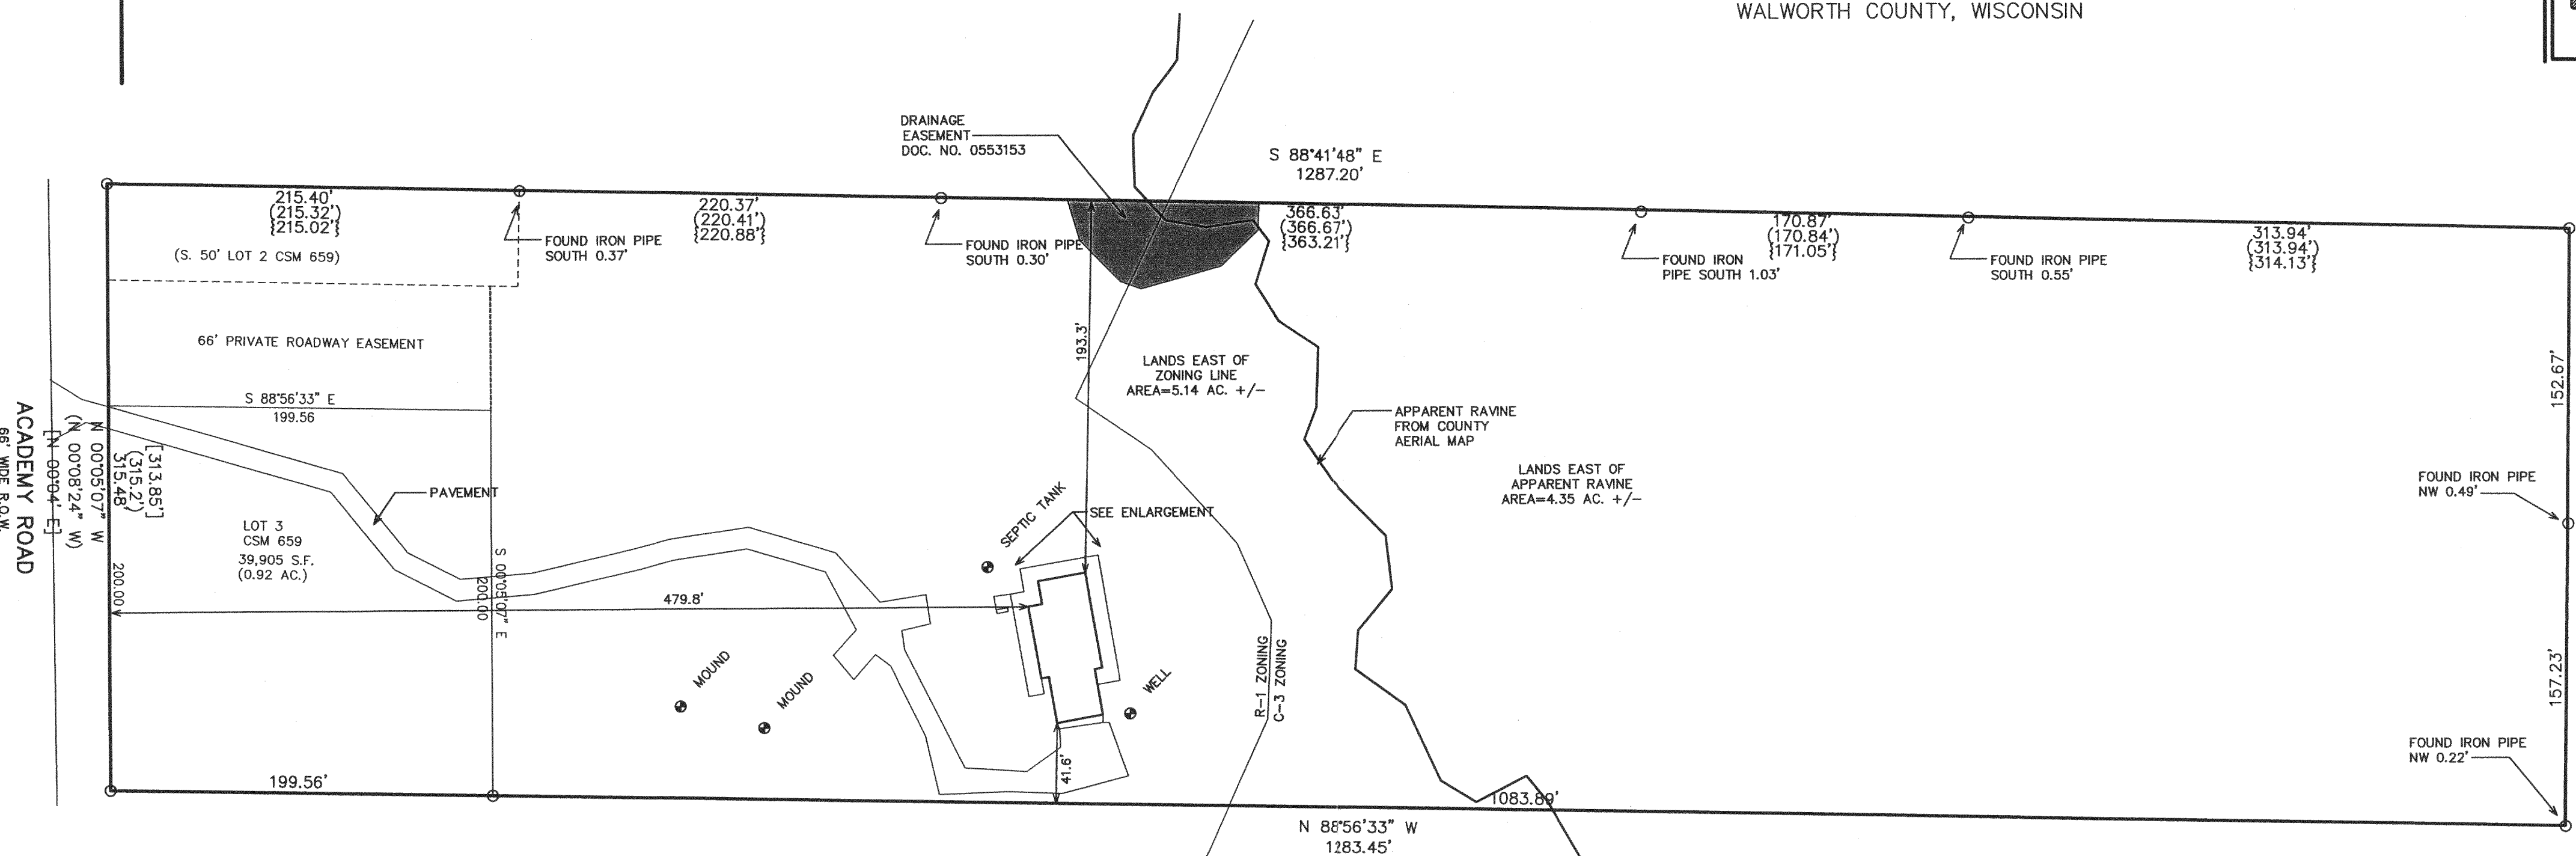

3. The land referred to in the Commitment is described as follows:
Commencing at a point in the North and South 1/8 Section line of Section 18, T1N, R17E, of the 4th Principal Meridian, Town of Lima, Walworth County, Wisconsin, said point being located on the centerline of Academy Road at the Southwest corner of Certified Survey Map No. 1472; thence S 88° 44' 20" E, 33.00 feet to an iron pipe stake found in the Easterly right of way of Academy Road; thence continue S 88° 44' 20" E, 1287.18 feet along the South line of said Certified Survey Map No. 1472 to an iron pipe stake found marking the Southeast corner thereof in the East line of the North 1/2 of the South 1/2 of the Northeast 1/4 of the Southeast 1/4 of said Section 18; thence S 0° 31' 44" W along said East line to an iron pipe stake found marking the Southeast corner of said North 1/2 of the South 1/2 of the Northeast 1/4 of the Southeast 1/4; thence N 88° 58' 20" W, 1283.45 feet along the South line of said North 1/2 of the South 1/2 of the Northeast 1/4 of the Southeast 1/4 as said South line was found to be monumented to an iron pipe stake found in the Easterly right of way of Academy Road; thence continue N 88° 58' 20" W, 33.00 feet to the 1/8 Section line and the centerline of Academy Road; thence N 0° 08' 24" W, 315.33 feet along said centerline to the point of beginning, EXCEPTING therefrom the Westerly 33 feet of the above-described parcel as now used for Academy Road right of way. The above-described premises contains Lot 3, part of Lot 2 and a private road 66-feet wide of Certified Survey Map No. 659, recorded in volume 3 of Certified Surveys on Page 144.

Tax Key No. IL1800026, IA65900002, IA65900003

— WORK ORDERED BY —
CHERYL MICK
C/O REMAX
101 BROAD STREET, SUITE 102
LAKE GENEVA, WI 53147


LEGEND
○ = FOUND IRON PIPE STAKE
(XXX) = RECORDED AS ON PREVIOUS 1989 SURVEY
{XXX} = RECORDED AS ON C.S.M. 1472
[XXX] = RECORDED AS FROM LEGAL DESCRIPTION
OVERALL AREA = 9.23 ACRES

NOTE: COPIES OF THIS MAP TO WHICH THE FOLLOWING CERTIFICATE WILL APPLY SHOW THE SURVEYOR'S ORIGINAL SEAL AND SIGNATURE IN RED INK. COPIES BY ANY OTHER MEANS MAY HAVE ALTERATIONS WHICH DO NOT REPRESENT THE SURVEYOR'S WORK PRODUCT.

I HEREBY CERTIFY THAT THE ABOVE DESCRIBED PROPERTY HAS BEEN SURVEYED UNDER MY DIRECTION AND THAT THE ABOVE MAP IS A TRUE REPRESENTATION THEREOF AND SHOWS THE SIZE AND LOCATION OF THE PROPERTY, ITS EXTERIOR BOUNDARIES, THE LOCATION OF ALL VISIBLE STRUCTURES, AND DIMENSIONS OF ALL PRINCIPLE BUILDINGS THEREON, BOUNDARY FENCES, APPARENT EASEMENTS, ROADWAYS, AND VISIBLE ENCROACHMENTS, IF ANY. THIS SURVEY IS MADE FOR THE USE OF THE PRESENT OWNERS OF THE PROPERTY, AND ALSO THOSE WHO PURCHASE, MORTGAGE, OR GUARANTEE THE TITLE THERETO WITHIN ONE YEAR FROM THE DATE HEREOF.

DATED: 11/03/03

Peter S. Gordon
PETER S. GORDON

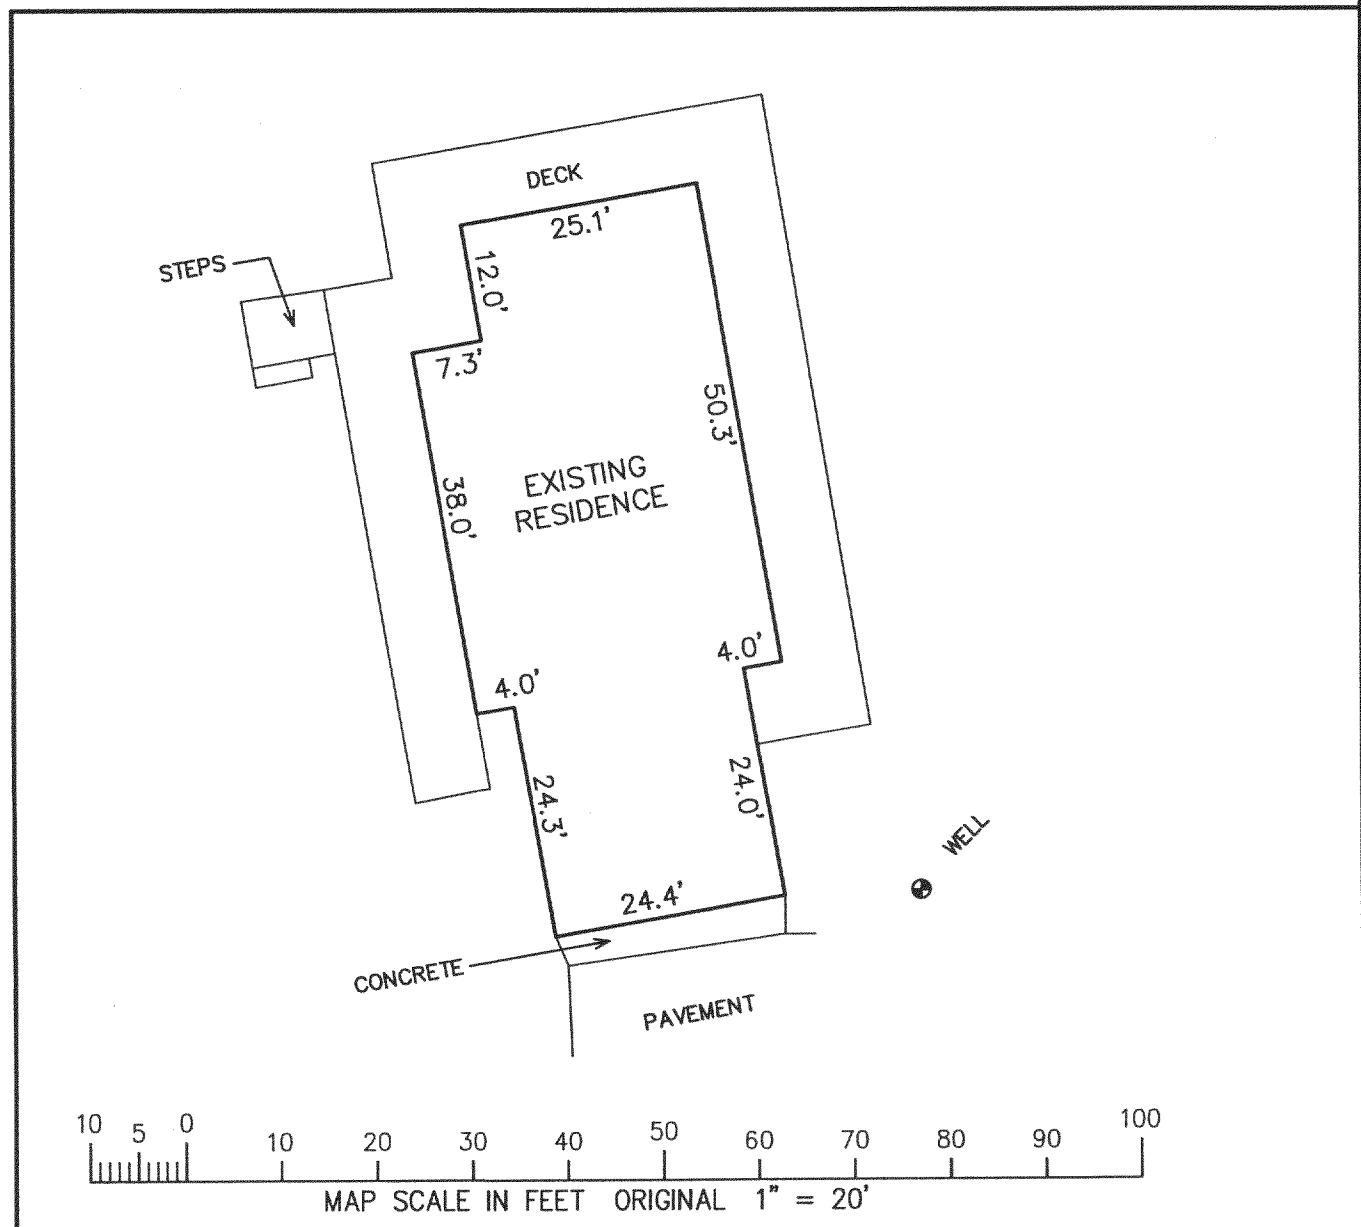

FARRIS, HANSEN & ASSOCIATES, INC.
ENGINEERING - ARCHITECTURE - SURVEYING
7 RIDGWAY COURT P.O. BOX 437
ELKHORN, WISCONSIN 53121
OFFICE: (262) 723-2098 FAX: (262) 723-5886

REVISIONS

PROJECT NO.
3137_02
DATE:
12/18/02
SHEET NO.
1 OF 1

MAP SCALE IN FEET ORIGINAL 1" = 60'

MAP SCALE IN FEET ORIGINAL 1" = 20'

IL 18-26
IA659-2
IA659-3

117-2382