

2

No. 13/31 Wm Wriggle

Survey begun for
Wm Wriggle Jr.
Found, and re-established 2u
34 + 35 - Town 2. N. Range 17.
Wisconsin. (This cor. Mon. had
stone set on end near the north
way builders. (a practice of
be stopped) The writer went
Geo. Posey before the road
several section, cor. Mon's
monumented & witnessed before
ed. so we established new
be carefully preserved, and
but the builders did not thus
stone at one side. The witness
an iron stake, with the original
it the witnesses are a large
N.W. ^{16.2} ft. distant a spike
distant 30.1 feet. Stake about 2"
of middle of a 3' square pillar
We question the previous location
surplus of 6' to the N. line
N.W. ^{1/4} of sect. 35 and a short
section. Location taken ~~from~~
former surveyor.
Having re-established this ^{1/4} cor.
proceeded to re-survey. The

2u

Lot known now as Fox farm,
formerly owned by Hambrecht then by
M. W. Harris of Chicago
after section cor. between sections

Town of Geneva, Walworth County
been removed (a flinty long pointed
highway track) by the concrete high-
highway commissioners that should
with the county highway engineer
was constructed and we witnessed
along route 50. (These had been
but some witnesses had been destroyed
witnesses. These Mon's were to
I think they were, by Mr. Posey
preserve this one for we found the
es were still there and we placed
stone set in the ground beside
spike in a 16" White Oak stump
in a post to picket fence N.E.
below surface, and 18ft. south
at corner of field surveyed
of this ^{1/4} cor. as there is a
of the S. line of the S. ^{1/4}, S.W. ^{1/4},
e. of 20ft. to south line of
from records of H. E. Haskins,

as previously established the
Fox farm, composed, of the

L-2-5A ✓ L-3-1A ✓
L-2-5 ✓ L-3-1B ✓


117-2384

at S. $\frac{3}{4}$ of the W. $\frac{1}{2}$, W. $\frac{1}{2}$ of R. 17 E
Measured N on the W. line 1985' to the center of the agrees exactly with former over Govt. road. The new pillars at 1985' measured former survey of 1984 as near the other as concrete The pillars at S. W. & S. E. fence posts at N. W. & N. E. cor. The road at the N. side is 64' wide and at S. W. Cor. $\frac{1}{2}$. or N. W. $\frac{1}{4}$ road is 66' wide wide. The south line of Fox W. $\frac{1}{4}$ cor. to the post N. E. cor. is 890' E. S. W. from said $\frac{1}{4}$ cor. A area = $1985.5 \times 660 = 133560$

Next measured S. road line E. of W. $\frac{1}{2}$ S. W. $\frac{1}{4}$ S. E. S. E. Then W. on S. road line 1716.8' to a 3' square fence set iron stakes as near No iron stk set at N. E. corner was set

the N. W. of section 35, T. 2, N. or the section front the road the highway on the N. line. which cor. survey shows a surplus of 5' East on S. line 660.9' E. side of N. line 660' and this agrees with set iron stakes at N. W. cor. and footings would permit. corners are on said roads and are at the respective corners 50' wide. At the S. E. cor. it is 49 $\frac{1}{2}$ ' wide. At the E. $\frac{1}{4}$ cor. it is running S. W. from $\frac{1}{4}$ cor. it is 49 $\frac{1}{2}$ ' farm runs N. S. 90' E. from the W. $\frac{1}{2}$ S. W. $\frac{1}{4}$ said section line runs road runs S. N. 60' E. it is 49 $\frac{1}{2}$ ' wide, more or less.

from W. line set 861' 1914. Cr. line N. line of Lytton farm. N. line Guinean land, the pillar, on N. W. cor. of Guinean N. W. cor. as concrete would permit.

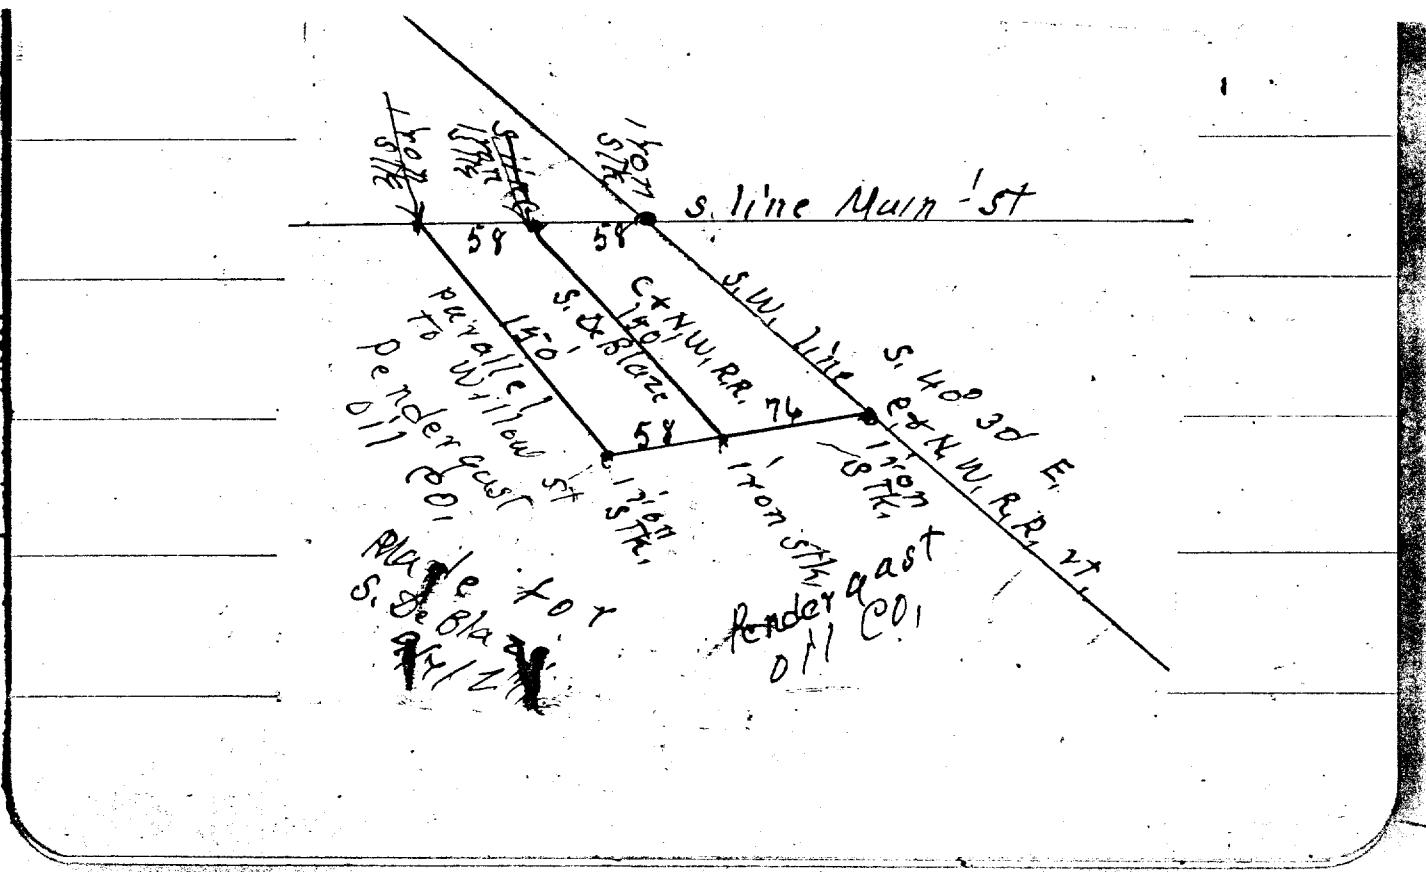

117-238-8f

4 Nov 16, continued

- Lytton farm
N. on sect line between
2598. S. road line to
N. road line,
2653' Town line 1 min & 8 sec.
to $\frac{1}{4}$ line 36' Overrun 13'
W. line Quineannon fence
185.92' entire length fence to
W. line entire to cr. of N. 1840
1878.2'
E. line fence to fence 1948'
509. S. W. cor. S. line 923' 2.42
E. line ~~231.5~~ 4830' acres
Entire cross E + W line at
N. line McCrea to W. line
1654'
345'. S. W. cor. Quineannon lot
to N. W. cor. McCrea lot
1337. N. E. cor. McCrea to N. E.
cor. Quinn 104. 317'
N. line 104. 317'
W. line McCrea
575' curve 1354 = 1999
722.5' Sect. line w. to E line
acres. E. W. line acre 446
S. W. cor. McCrea to road line
575' slant 68. slant to W. line
acre. 1964.5

Survey Wrigley farms.

sects. 344 35

N & S line of acre 124.5'
1,248' without road,
188' with
Area McCrea 'Lot 28, 44 acres

Sect. cor. W. to Glennon 614.5'

" " E. to Lytton 398'

Wrigley N. line 1009'

" N. line E. of sect cor. 398'

" cor. to N. E. cor. Lytton now P.M. Wrigley 360'

Sect. cor. to S. E. cor. Lytton 1320'

Sect. line S. of Large house

W. to Glennon E. line 588'

W. line of Strong's lot (which is
E. line P.K. Wrigley's lot) by
Strong's deed should be 4.3' E. of
present (1931) fence at N. end
and 3.0' at south end.

Said line of fence now measures

1961' cr. of road to lake, and

1960' cr. or road to iron stk

at shore. Each line is 25'

less from road fence.

Width of lot is 360' ft. at

each end. Strong's N.W. cor.

by deed is 762.3' E. of cor. of sect 2-1-17

5 Nov. 17 1931 cont'd
Wm Wrigley Jr. & P. K. Wrigley
With transit line & Wm Wrigley's
N.E. cor to lake using N end
of fence and retaining wall
as a part of said line.
Line from ctr. of road to lake
2156' to iron st^t 2144'
Checked line by measure from
E. line 360' and by needle
(var. 10 ft) check O.K.
Measured across. Wm Wrigley's
original lot 898' to E.
line Williams lot & thence
west at right angles to
Glenndon's E. line 588'
E. line Williams lot 18' sect
line between sects (2+3)-1-17,
corresponding line at
N. Twp. line measures 510.5'
Mr. Dooley says Wm.
Glenndon's will be O.K. but
we are to show the
strip E. of E. fence P. K.
Wrigley's land.
Glenndon's line varies
to east of S. end
about 22'.

Witnesses to S. Sect Cor. 34835
Owner of Geneva Wm Wrigley

Post 18, Cor. 34835
WITNESSES Post, Bym^t 12", N 34° E, 17, 82'
W.O. 10" N 70° W 60, 72'
SOUT Sector 2+3 → N. 17 E,
WITNESS^t Lymc 12" S. 68° W 26, 12'
W.O. 10" S. 72° E 36, 96'

Wt. to 1/4 Cde. 34+35 2-14
Sobt, S N. 80° 20" W.O. STUNN^t (Dist)
Wt. N. E. Spike in fence post
Dist, 30.1
E^ts of fence pillar 18' North
IRON PIPE + original stone
Near N. edge of pavement

11/21/31
Survey completed
Ran line between sects 2+3
Line W.M. 91(0.14
hard 20'
22 54. 24' long
Varied a few inches from
point measured across
near lake. N.E. cor Williams
at 14 27. 26 0.13 set iron st^t
near P.O. in water, 40' long
19" maple blazed near lake

