


PLAT OF SURVEY

LOTS 4-6 & 26-27, BLOCK 2 OF MAPLE HILLS "A" SUBDIVISION
 LOCATED IN SECTION 18, TOWN 1 NORTH, RANGE 17 EAST,
 TOWN OF LINN, WALWORTH COUNTY, WISCONSIN

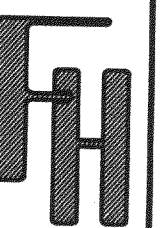


WORK ORDERED BY -
 BILL DOERRIES
 11361 SUMMIT DRIVE
 FONTANA, WI 53125

FARRIS, HANSEN & ASSOCIATES, INC.
 ENGINEERING - ARCHITECTURE - SURVEYING
 7 RIDGWAY COURT P.O. BOX 437
 ELKHORN, WISCONSIN 53121
 OFFICE: (262) 723-2098 FAX: (262) 723-5886


REVISIONS

PROJECT NO.
 6461
 DATE:
 01/14/04
 SHEET NO.
 1 OF 1

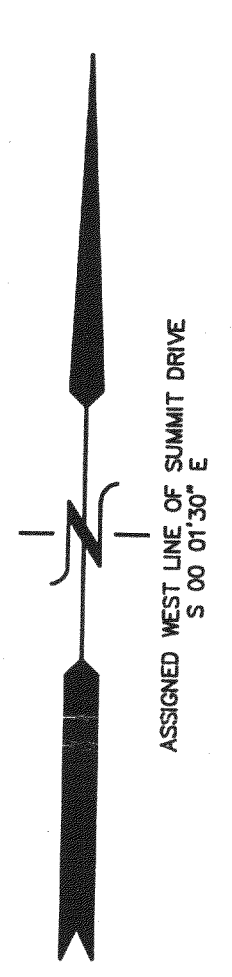

EDGE OF PAVEMENT
 GREENHILL DRIVE
 50' WIDE R.O.W.

EDGE OF PAVEMENT
 SUMMIT DRIVE
 50' WIDE R.O.W.

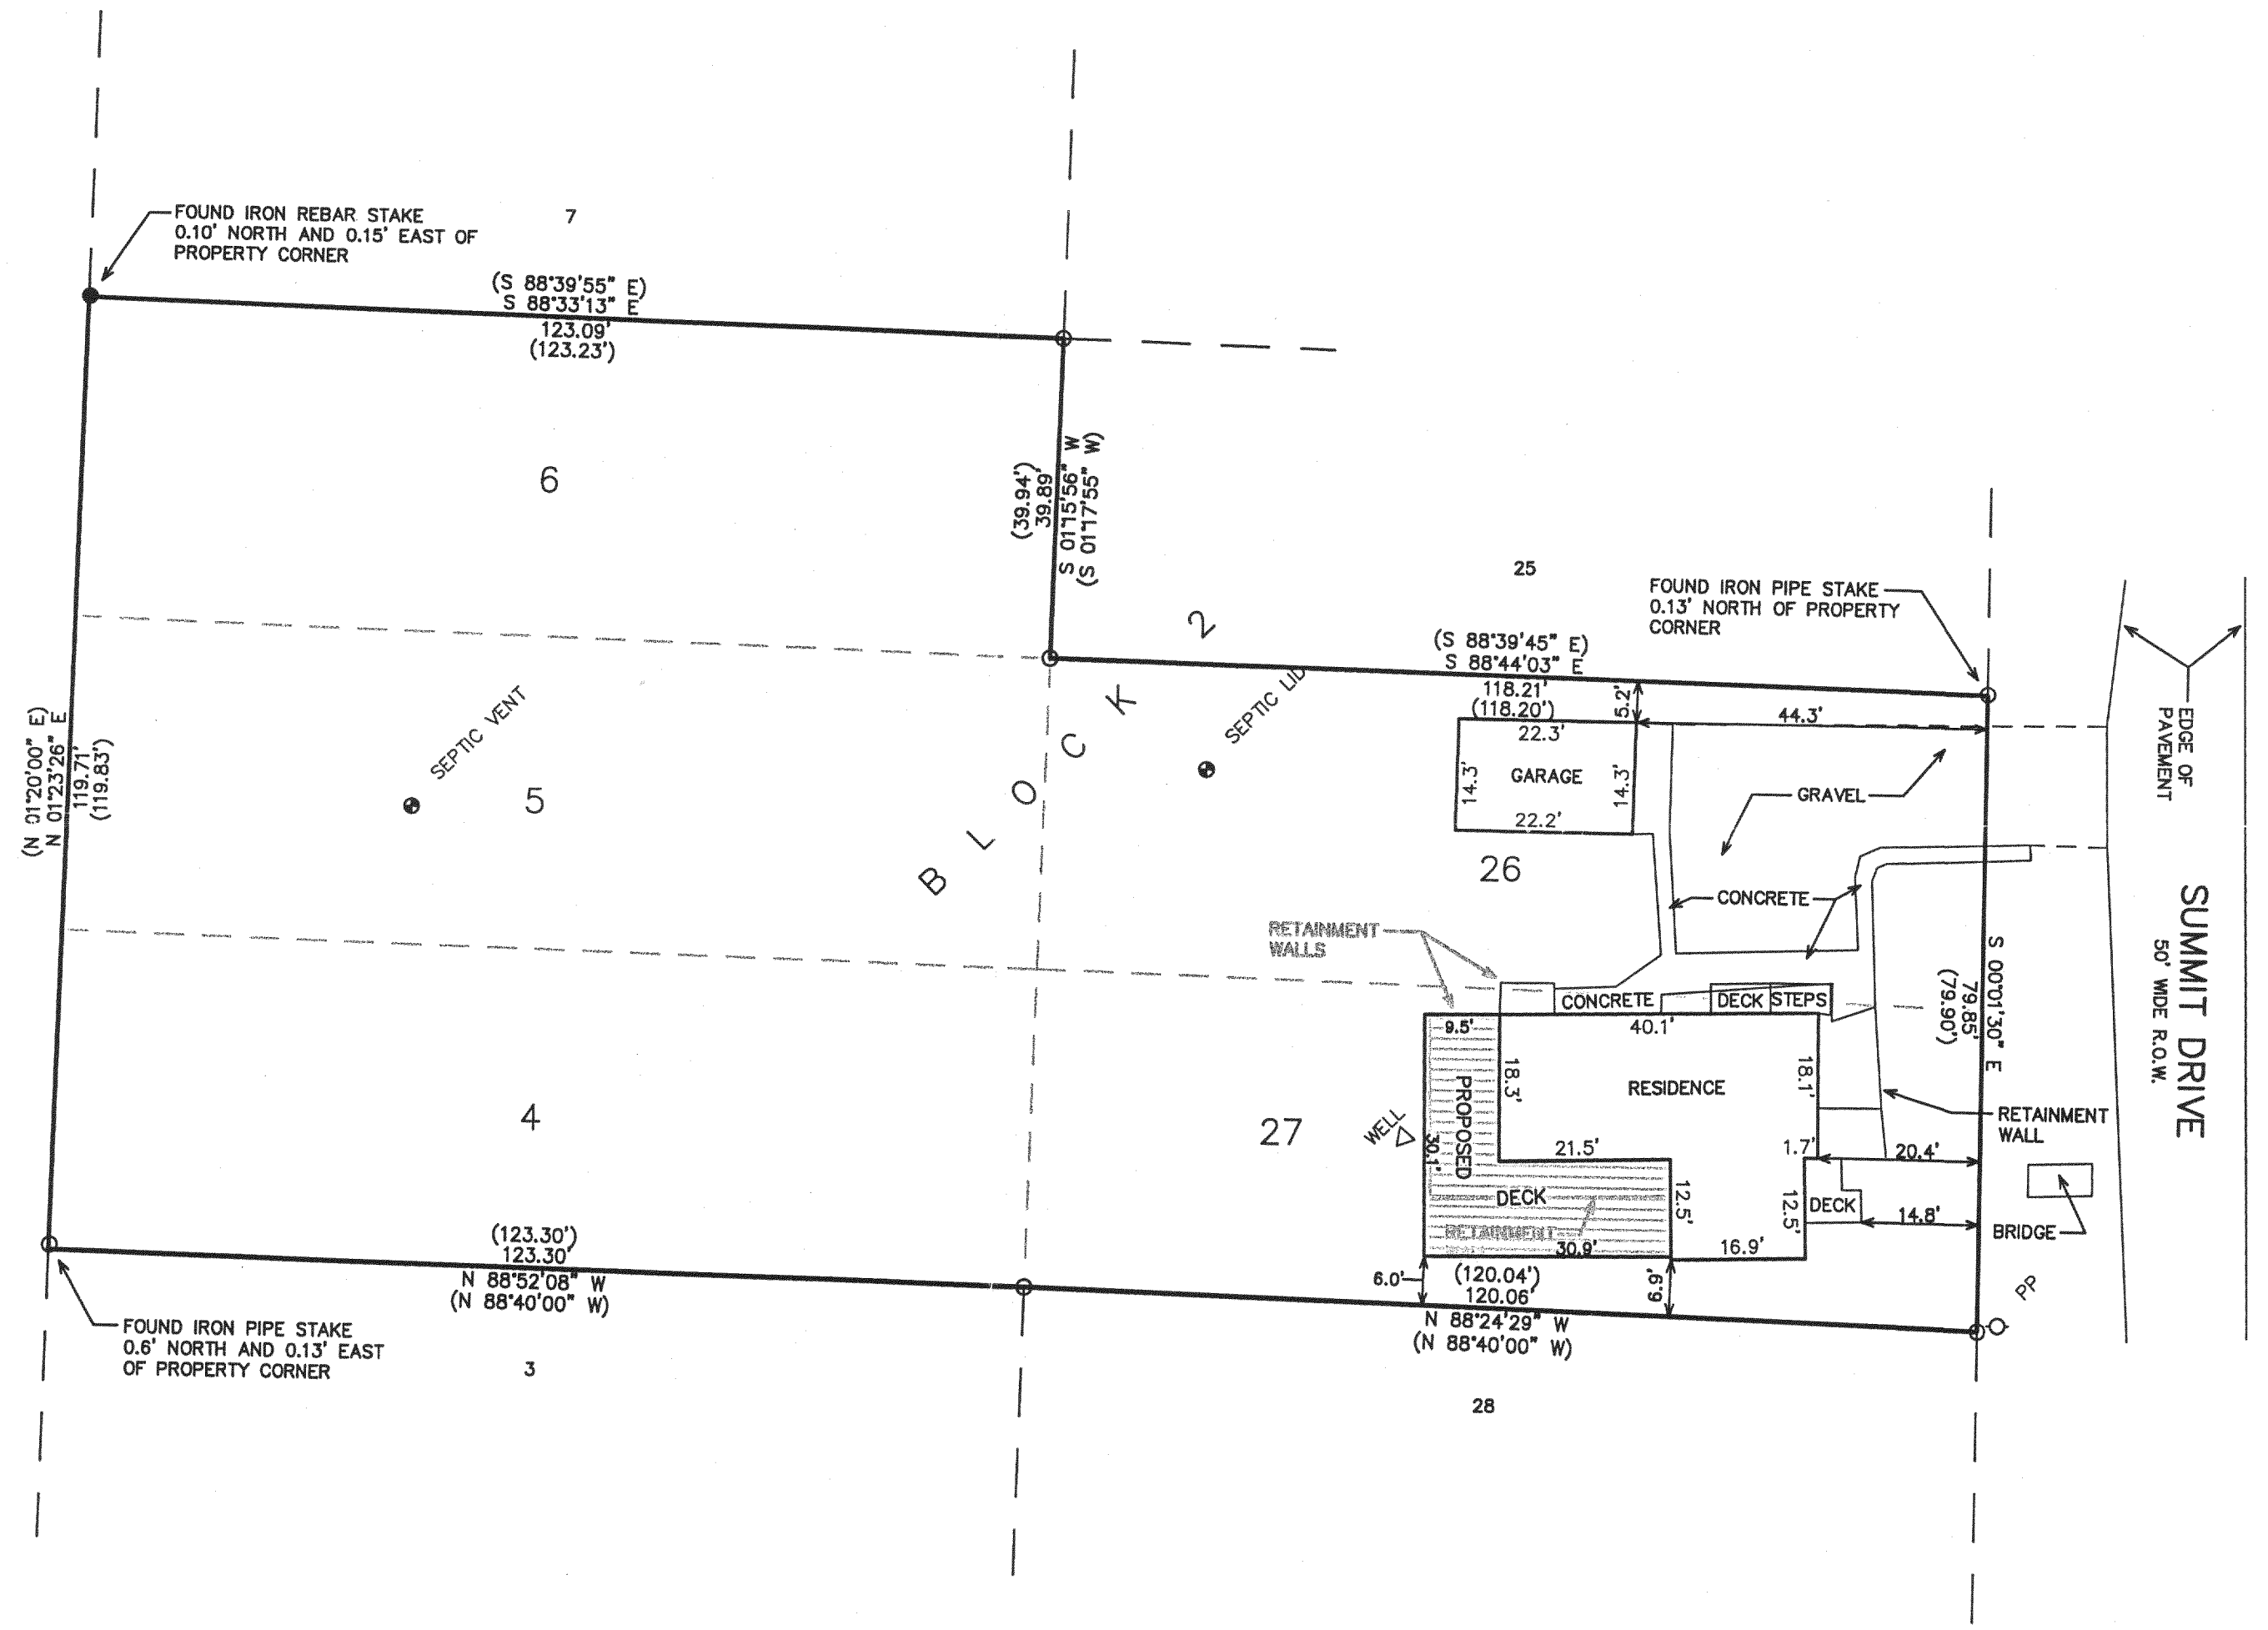

- LEGEND
- = FOUND IRON PIPE STAKE
 - = FOUND IRON REBAR STAKE
 - (XXX) = RECORDED AS




NOTE: COPIES OF THIS MAP TO WHICH THE FOLLOWING CERTIFICATE WILL APPLY SHOW THE SURVEYOR'S ORIGINAL SEAL AND SIGNATURE IN RED INK. COPIES BY ANY OTHER MEANS MAY HAVE ALTERATIONS WHICH DO NOT REPRESENT THE SURVEYOR'S WORK PRODUCT.

I HEREBY CERTIFY THAT THE ABOVE DESCRIBED PROPERTY HAS BEEN SURVEYED UNDER MY DIRECTION AND THAT THE ABOVE MAP IS A TRUE REPRESENTATION THEREOF AND SHOWS THE SIZE AND LOCATION OF THE PROPERTY AND ITS EXTERIOR BOUNDARIES. THIS SURVEY IS MADE FOR THE USE OF THE PRESENT OWNERS OF THE PROPERTY, AND ALSO THOSE WHO PURCHASE, MORTGAGE, OR GUARANTEE THE TITLE THERETO WITHIN ONE YEAR FROM THE DATE HEREOF.

DATED: JANUARY 14, 2004

Peter S. Gordon
 PETER S. GORDON R.L.S. 2101

REVISED 01-20-2004
 TO SHOW SIZE & LOCATION OF
 PROPOSED DECK

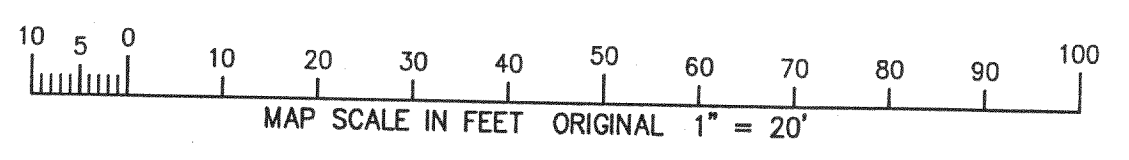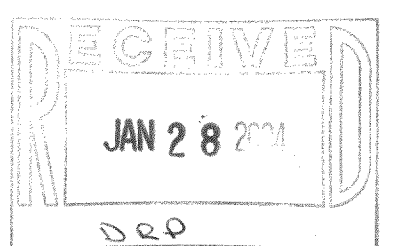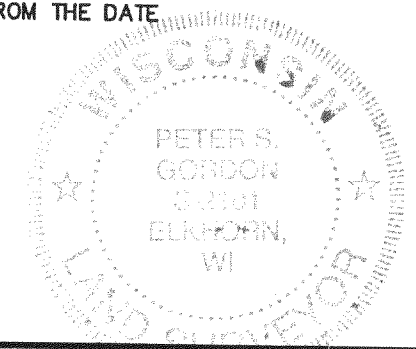

1/20/2004 X:\Projects\6461\Draw\SURVEY

IMH-15
 IMH-35

117-2391