PREPARED FOR: CJ INVESTMENTS, INC. C/O JIM MULLEN 1200 PHEASANT CT. LAKE GENEVA, WI 53147

( )= recorded as

= found iron bar

= found iron pipe

= set iron pipe= set iron bar

SCALE 1" = 20'


JOB # 04-014

(AX ID # ILGT00032A1

## PLAT OF SURVEY

J.K. SURVEYING INC. N3705 WILLOWBEND LANE LAKE GENEVA, WI, 53147 262-248-3697



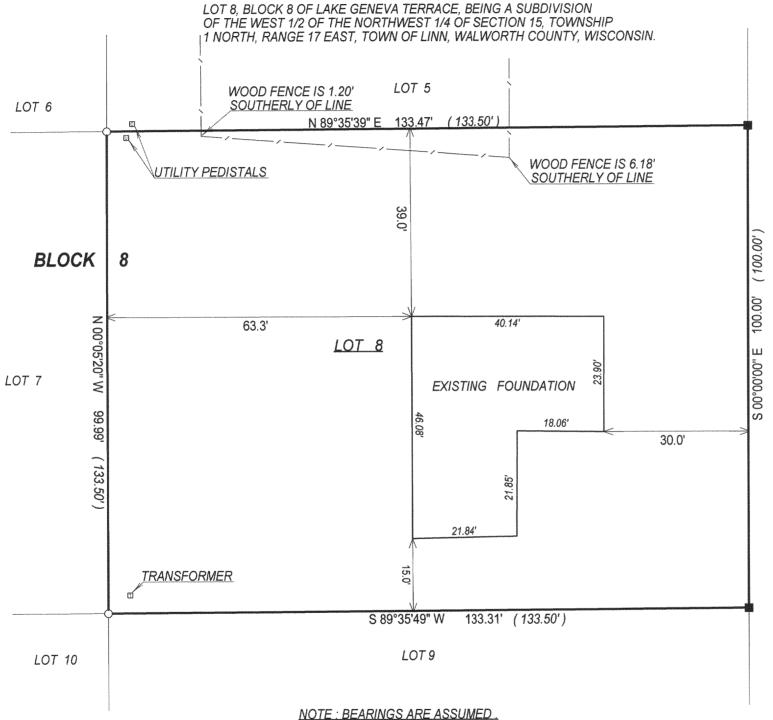



COMPARE LEGAL DESCRIPTION ABOVE AND DRAWING WITH DEED. FOR BUILDING RESTRICTIONS AND EASEMENTS NOT SHOWN, REFER TO DEED. ABSTRACT SOURCES AND LOCAL MUNICIPAL CODES. NOTIFY THE SURVEYOR IMMEDIATELY OF ANY DISCREPANCY.

"I hereby certify that I have surveyed the above described property and that the above map is a true representation thereof and shows the size and location of all visible structures, apparent easements and encroachments if any."

This survey is made for the present owners of the property, and those who purchase, mortgage, or guarantee the title thereto, within one year from the date hereof.





(76' WIDE ROAD)

JOHN KROTT S - 2258
Wisconsin Registered Land Surveyor
( original if signed in red )

DATED THIS THE 16th DAY OF JANUARY 2004.

117-2409