

By request of Mrs. Louise Boyd Dickinson, we have surveyed and subdivided the tract of land as herein shown.

This map correctly represents the Survey.

2" by 16" stakes are set at all points marked "• 5th". Said contains 2.07 acres more or less.

Lines numbered 1 to 7 are lines of 8ths. 1, 2, 5 & 6 are at rt. angles to the  $\frac{1}{4}$  line. Angles are on line except All fences are on line except the north part of west line which is  $\frac{1}{2}$  to  $1\frac{1}{2}$  west. Tract is divided into 5 very desirable lots of equal width.

Sept. 28, 1922 J. G. Skeels, C.E.  
Bessie M. Palmer, R.P.

Scale 100 to 1" -  $\frac{1}{4}$  Sect. Line 11-1-17

500 $\frac{1}{2}$

Lot 5      Lot 4      Lot 3      Lot 2      Lot 1

Timber  
Large Oaks.

Total area 2.07 acres

Chas. Wacker

Section 11-1-17  
N. 10 M.

100' 100' 100' 100' 100' 100'

100' 100' 100' 100' 100' 100'

request of Mrs. Louise Boyd  
Kinson, we have surveyed and  
subdivided the tract of land  
as herein shown.

is map correctly represents this  
trueq.

6416" stakes are set at all  
int's marked "5th"  
id contains 20.7 acres more  
- less.

lines numbered 4 to 7 are  
lines of stks.  
lines 1, 2, 5+6 are at rt.  
angles to the  $\frac{1}{2}$  line.  
1 fences are on line except  
the north part of west line  
which is  $\frac{1}{2}'$  to  $1\frac{1}{2}'$  west,  
and it is divided into 3  
very desirable lots of  
equal width.

28.11.22. J. G. Skeels, C.E.  
Bessie M. Palmer, A.R.

S. D. County

55 May 13 & 15-


re-surveyed line  
Sickinson's subdivision  
to E 1/8 line Sect. 11,  
and measured over 200'  
required. Set on stke  
turned & rt. L. and  
found old stke at  
line N. to lake shore.  
ran directly over  
no others found.  
Set stks at intervals  
between Lots 2 & 3.  
Slow work thru timber  
scrub jungle very  
thick wall closett

A. B. Sickinson

between lots 2 & 3.  
ion. Set line at rt L.  
T 1 N R 17 E, Line, L. is  
and set stake off line  
at end of line. and sighted  
sighted South road fence  
road fence, continued  
Opp. Kimball house line  
another old stke.  
all along the line,  
on account of heavy  
dense, is nearly all on lot 2.

Line between L-11-6 and L-11-4, L-11-5 + L-11-7

117-240 1

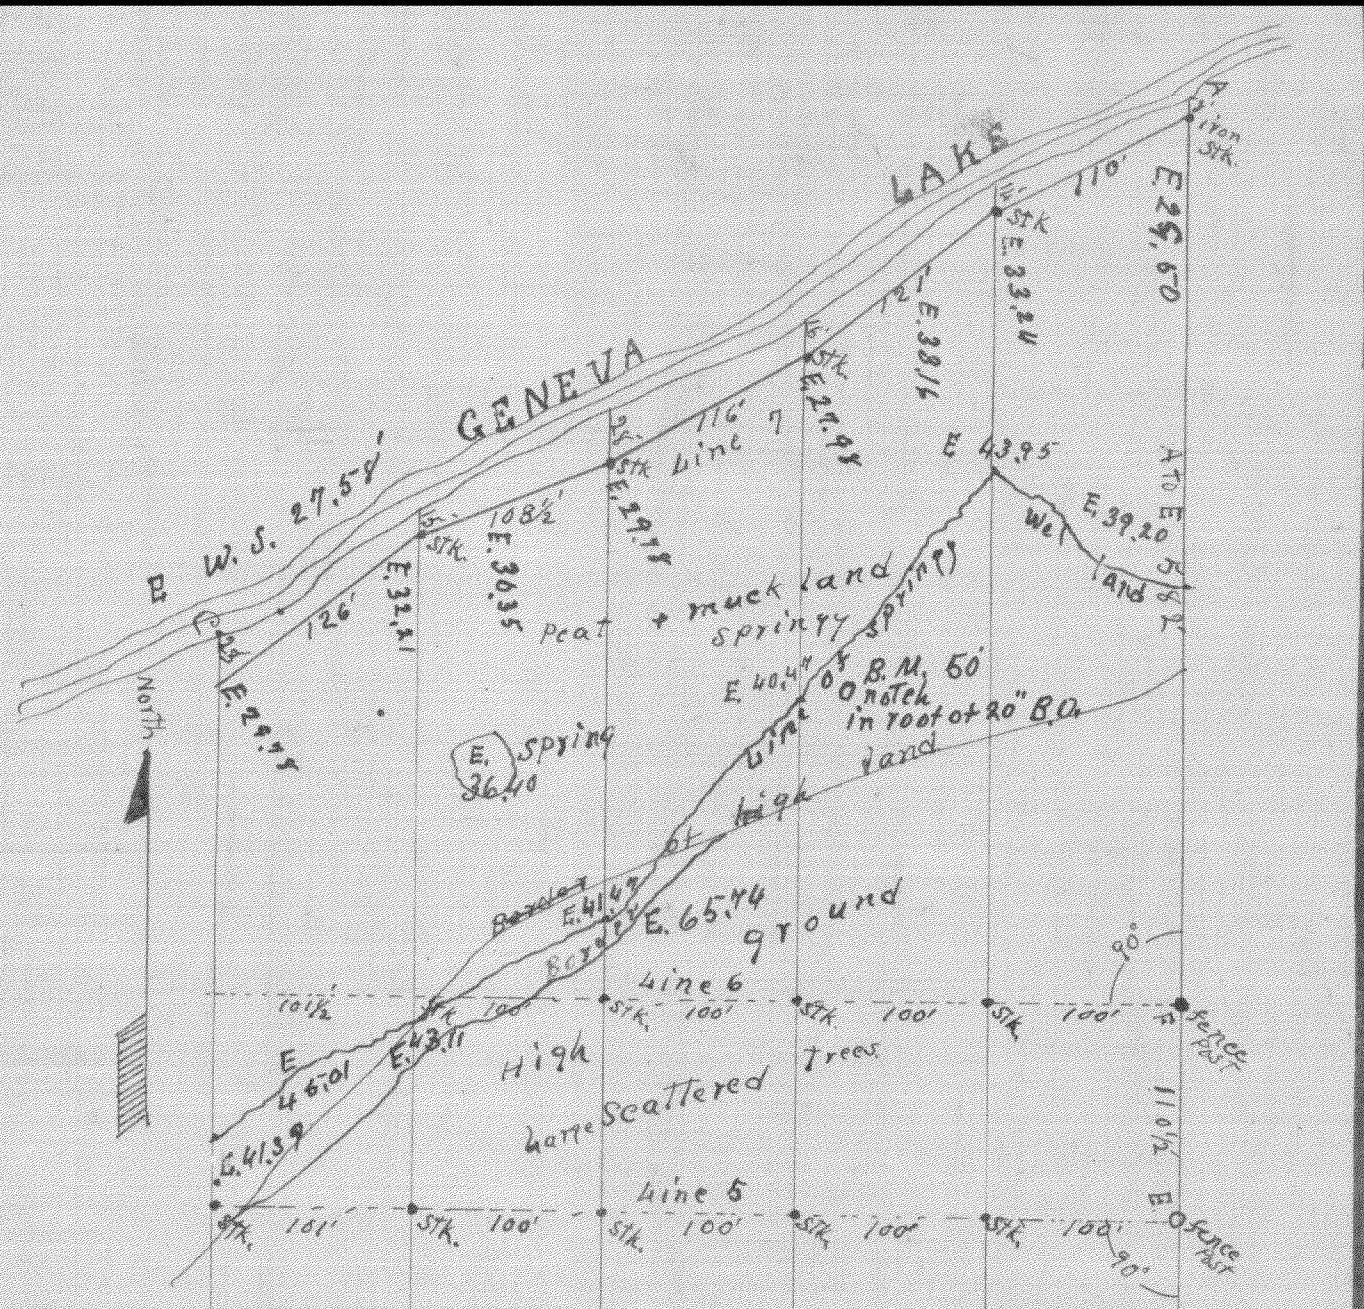

By request of Mrs. Louise Boyd  
Dickinson, we have surveyed and  
Subdivided the tract of land  
as hereon shown.

Scale 100 to 1" - 44 Sect. Line 11-1-17  
500 $\frac{1}{2}$ '

This map correctly represents the Survey.

2" by 16" stakes are set at all

points marked "STK,"  
said contains 80.7 acres more  
or less.

Lines numbered 1 to 7 are  
lines of 8ths.  
Lines 1, 2, 5 & 6 are at rt.  
angles to the  $\frac{1}{8}$  line.  
All fences are on line except  
the north part of west line  
which is  $\frac{1}{2}$  to  $1\frac{1}{2}$  West.  
Tract is divided into 5  
very desirable lots of  
equal width.

Sept. 28, 1922 J. G. Sheehan, C.E.  
Bessie M. Palmer, M.A.


Scale 100' to 0'

39 C. To D. Since 8A

total area 20.7 acres

South line of Timber  
line 4

Chas. Wacker

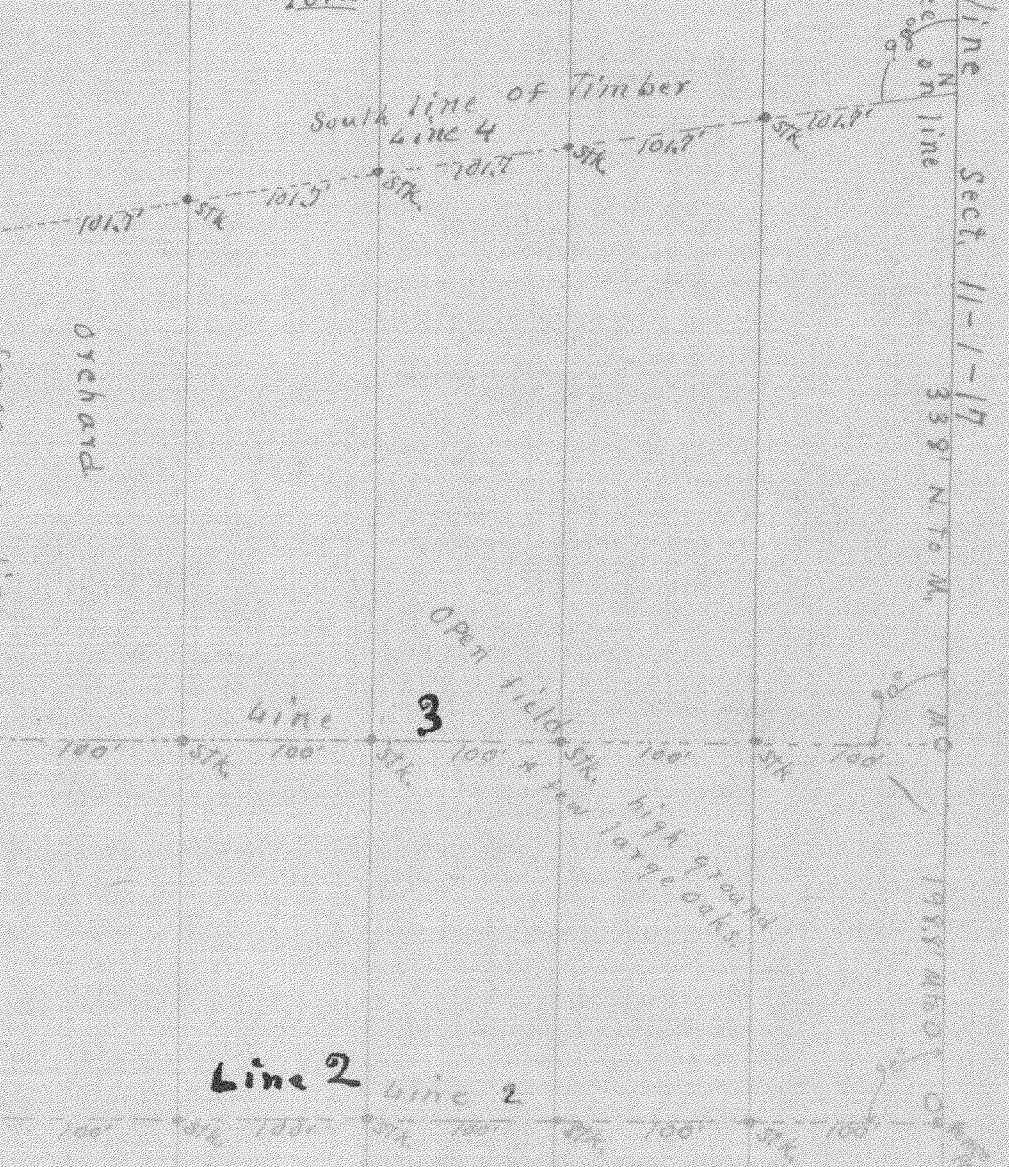

Line 2

10

卷之三