


# PLAT OF SURVEY

- OF -

J.K. SURVEYING INC.  
N3705 WILLOWBEND LANE  
LAKE GENEVA, WI, 53147  
262-248-3697

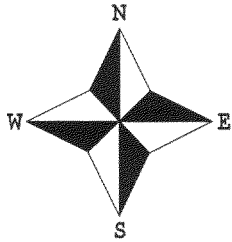

THE SOUTH 75.00 FEET OF LOT 9, THE NORTH 62.50 FEET OF LOT 12, AND THAT PORTION OF THE WEST 12 FEET OF WILLIAMS PLAZA BOUNDED ON THE NORTH BY THE EASTERLY EXTENSION OF THE NORTH LINE OF THE SOUTH 75.00 FEET OF LOT 9 AND ON THE SOUTH BY THE EASTERLY EXTENSION OF THE SOUTH LINE OF THE NORTH 62.50 FEET OF LOT 12, BLOCK 3, LAKE GENEVA TERRACE, A SUBDIVISION LOCATED IN SECTION 15, TOWN 1 NORTH, RANGE 17 EAST, TOWN OF LINN, WALWORTH COUNTY, WISCONSIN.

LOT 8

LOT 7

LOT 9

N 89°37'27" E 141.98' (142.00')  
129.98' (130.00')

UTILITY PEDISTALS

24.80'

LOT 10

LOT 9

N 00°01'04" W 137.44' (137.50')

112.64'

LOT 12

137.40' (137.50')

VACATED STREET

S 00°00'00" E 137.43' (137.50')

(66' WIDE ROAD)

C.L. WILLIAMS PLAZA

LOT 11

129.93' (130.00')

N 89°37'04" E 141.93' (142.00')

12.00'

12.34'



3

LOT 12

LOT 13

LOT 14

PREPARED FOR : CENTURY 21 PAGLIARINI GROUP INC.  
STACEY WHITING  
252 CENTER STREET  
LAKE GENEVA WI. 53147

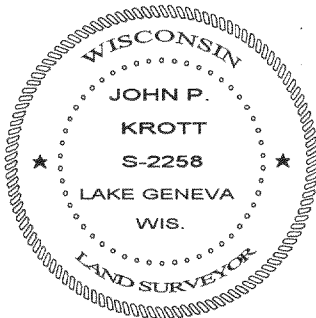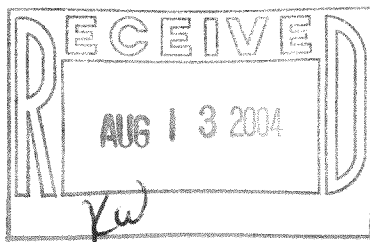

- ( ) = recorded as  
□ = found iron bar  
○ = found iron pipe  
● = set iron pipe  
■ = set iron bar

SCALE 1" = 20'

JOB # 04-230

TAX ID # ILGT00009C2

COMPARE LEGAL DESCRIPTION ABOVE AND DRAWING WITH DEED. FOR BUILDING RESTRICTIONS AND EASEMENTS NOT SHOWN, REFER TO DEED, ABSTRACT SOURCES AND LOCAL MUNICIPAL CODES. NOTIFY THE SURVEYOR IMMEDIATELY OF ANY DISCREPANCY.

"I hereby certify that I have surveyed the above described property and that the above map, to the best of my knowledge and belief, is a true representation thereof and shows the size and location of all visible structures, apparent easements and encroachments if any."

This survey is made for the present owners of the property, and those who purchase, mortgage, or guarantee the title thereto, within one year from the date hereof.

*John P. Krott*  
JOHN KROTT S - 2258  
Wisconsin Registered Land Surveyor  
(original if signed in red)

DATED THIS THE 13th DAY OF MAY 2004.

117-2458