


# AS-BUILT MAPPING

UNIT 37  
SOUTH SHORE CLUB ON LAKE GENEVA  
A CONDOMINIUM  
REC. IN CAB. A, SLIDE 394, DOC. NO. 500527  
TO REDEFINE THE SIZE & LOCATION  
OF UNIT 12

LOCATED IN CERTIFIED SURVEY MAP 2631  
RECORDED IN VOL. 13 OF CERTIFIED SURVEYS  
ON PAGE 171, AS DOCUMENT NUMBER 311927  
BEING IN ALL 1/4'S OF NE 1/4 OF  
SECTION 18, TOWN 1 NORTH, RANGE 17 EAST  
WALWORTH COUNTY, WISCONSIN

GRID NORTH  
WISCONSIN COORDINATE SYSTEM  
SOUTH ZONE  
ASSIGNED SOUTH LINE NE 1/4  
18-1-17  
S 89°30'42" W


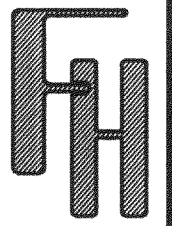


— WORK ORDERED BY —  
ORREN PICKELL  
DESIGNERS & BUILDERS  
2201 WAUKEGAN ROAD, SUITE W-285  
BANNOCKBURN, IL 60015

FARRIS, HANSEN & ASSOCIATES, INC.  
ENGINEERING — ARCHITECTURE — SURVEYING  
7 RIDGWAY COURT P.O. BOX 437  
ELKHORN, WISCONSIN 53121  
OFFICE: (262) 723-2098 FAX: (262) 723-5886

REVISIONS

PROJECT NO.  
4161.37  
DATE:  
12/12/03  
SHEET NO.  
1 OF 1

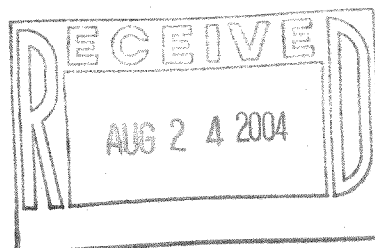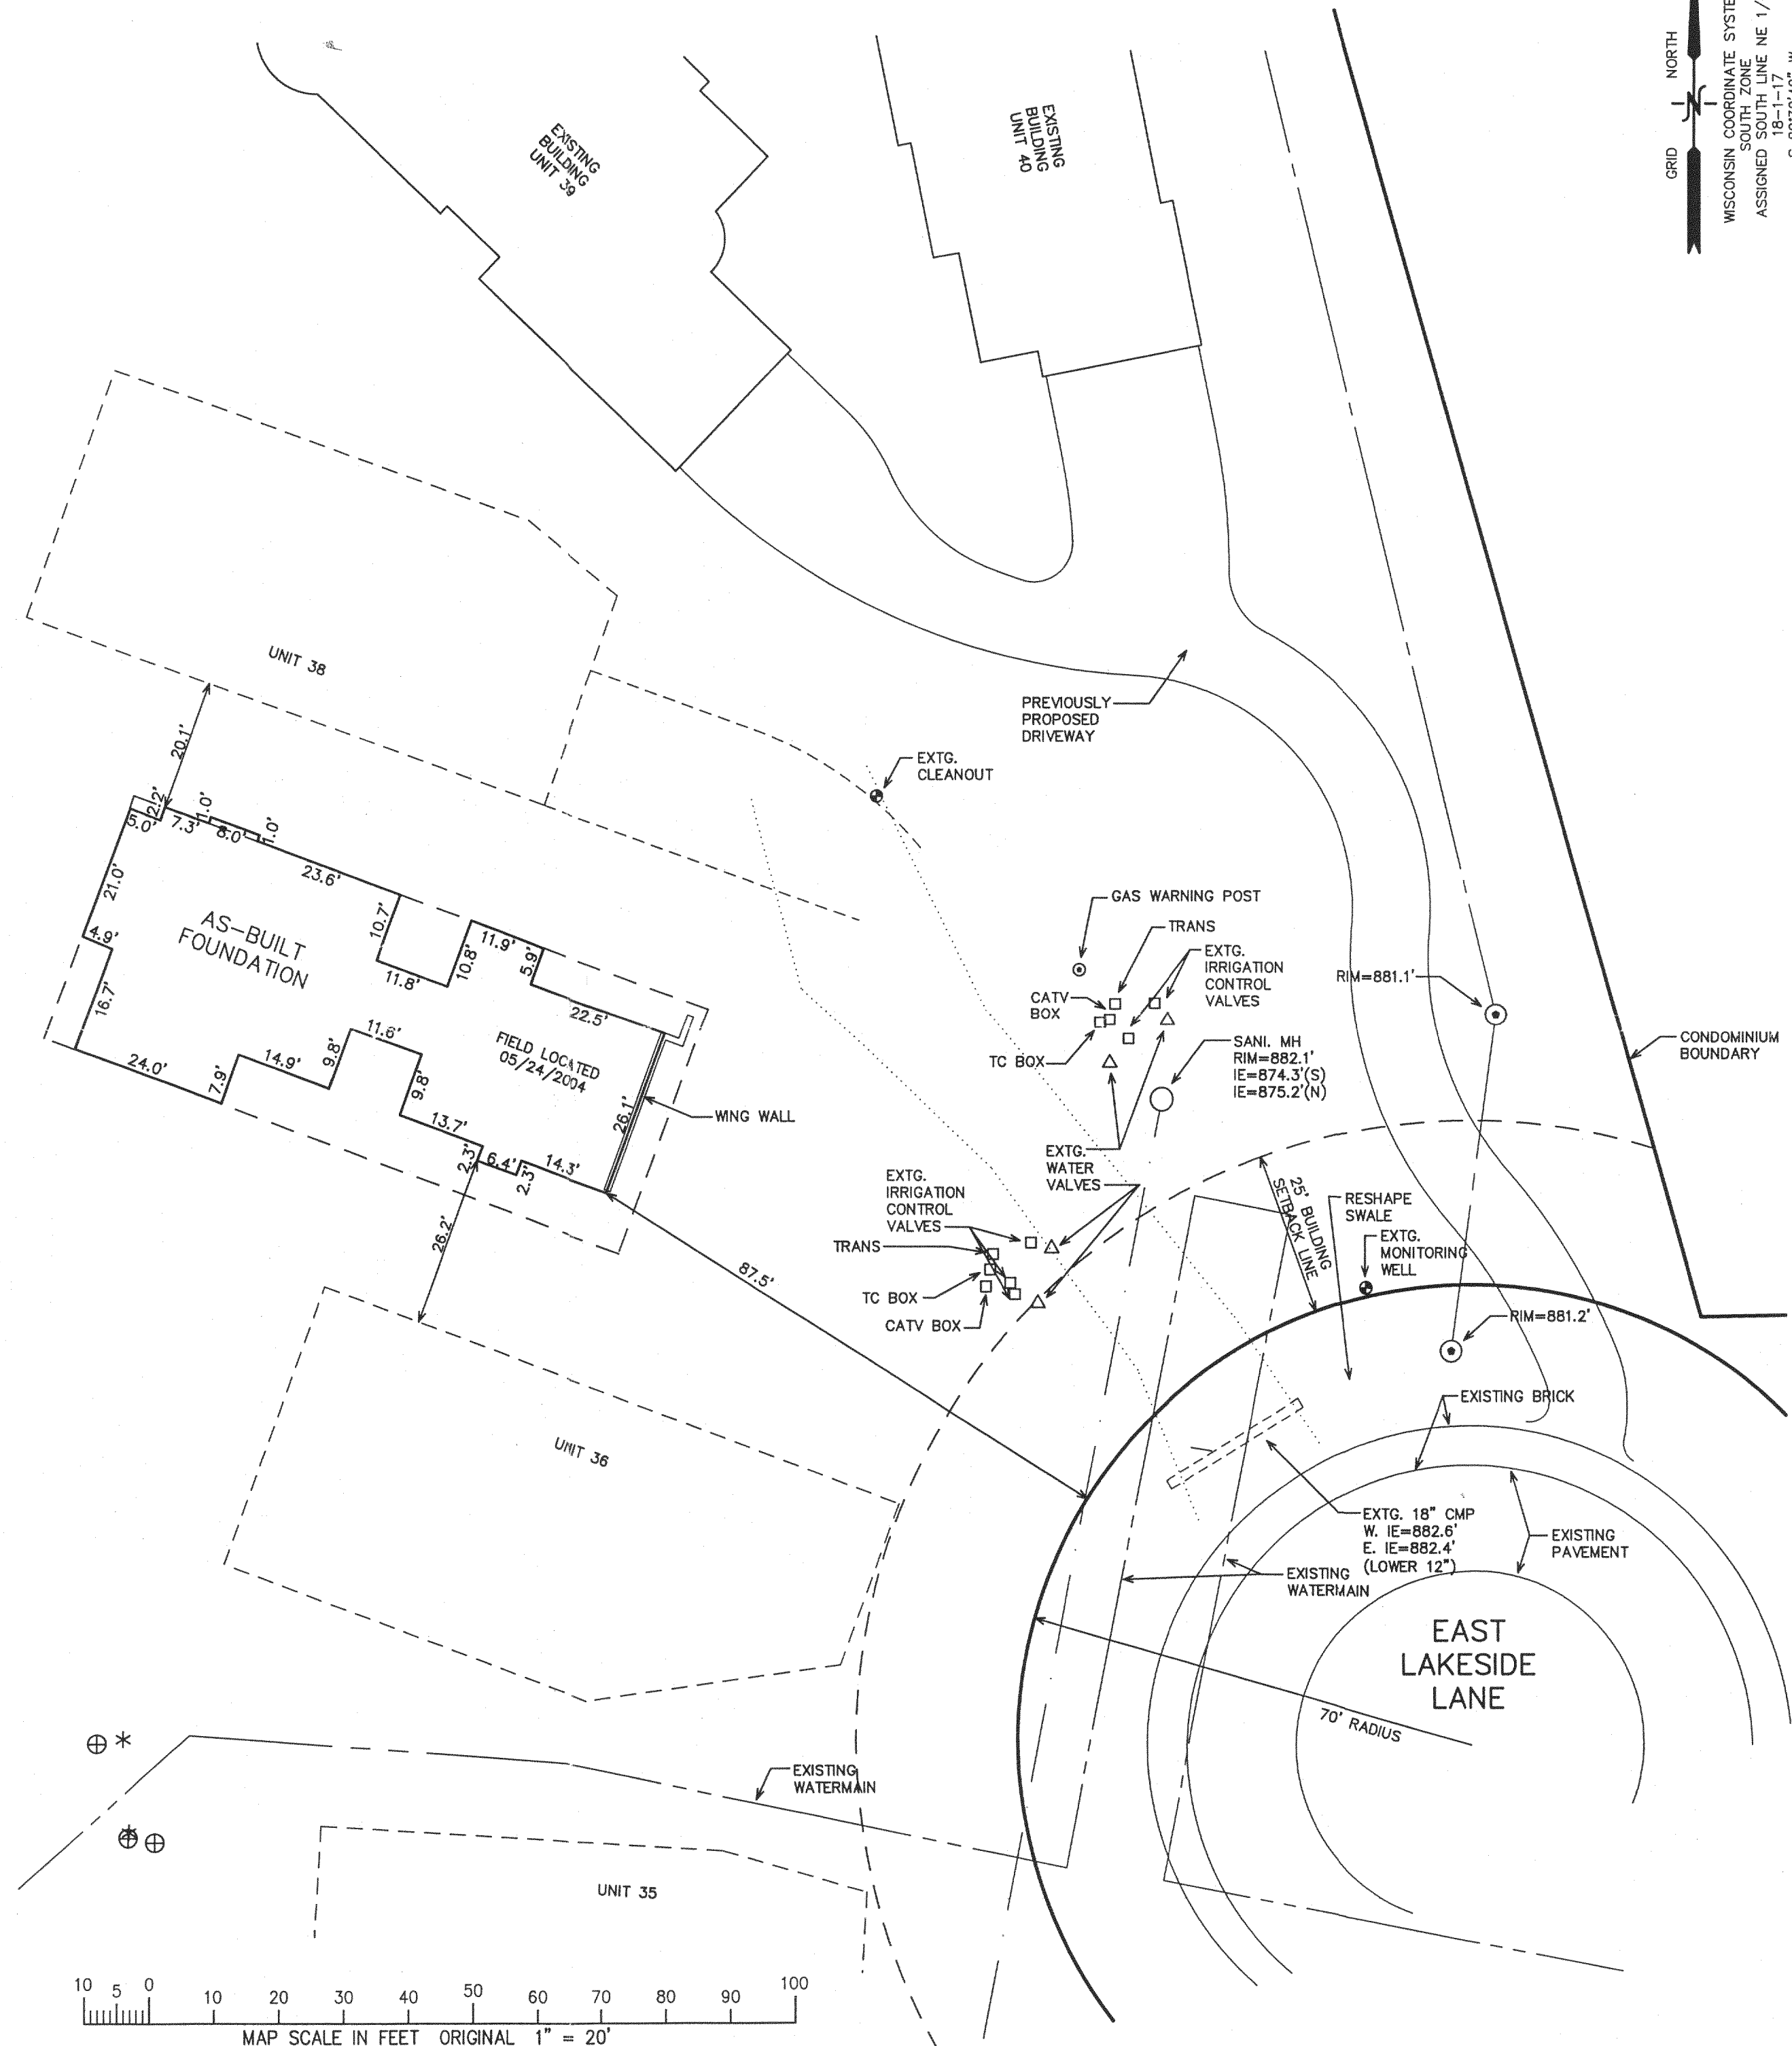

NOTE: COPIES OF THIS MAP TO WHICH THE FOLLOWING CERTIFICATE WILL APPLY SHOW SURVEYOR'S ORIGINAL SEAL AND SIGNATURE IN RED INK. COPIES BY ANY OTHER MEANS MAY HAVE ALTERATIONS WHICH DO NOT REPRESENT THE SURVEYOR'S WORK PRODUCT.

I HEREBY CERTIFY THAT THE ABOVE DESCRIBED PROPERTY HAS BEEN SURVEYED UNDER MY DIRECTION AND THAT THE ABOVE MAP IS A TRUE REPRESENTATION THEREOF AND SHOWS THE SIZE AND LOCATION OF THE PROPERTY AND ITS EXTERIOR BOUNDARIES. THIS SURVEY IS MADE FOR THE USE OF THE PRESENT OWNERS OF THE PROPERTY, AND ALSO THOSE WHO PURCHASE, MORTGAGE, OR GUARANTEE THE TITLE THERETO WITHIN ONE YEAR FROM THE DATE HEREOF.

DATED: DECEMBER 30, 2003

REVISED 07/07/2004  
SHOW SIZE & LOCATION OF  
AS-BUILT FOUNDATION

PETER S. GORDON R.L.S. 2101

ISSC 00037

117-2471