
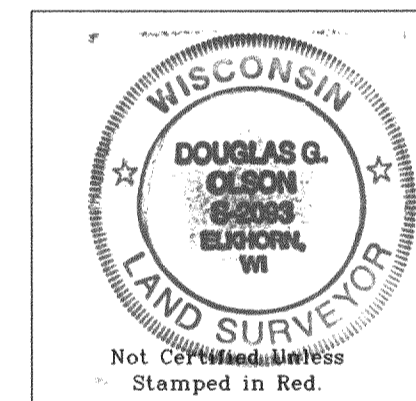


of

**Lots 9 and 34 in Block H of Cisco Beach,**  
a subdivision located in the Northeast 1/4 of Section 5, Town 1  
North, Range 17 East, Town of Linn, Walworth County, Wisconsin.




Bearings reference to Certified  
Survey Map No. 1674.



Notes: 1) The survey plat is not certified unless signed and sealed in red ink.

2) This survey is subject to Wisconsin lien laws. This Plat of Survey is the notice of intent to file lien. Lien waiver required.

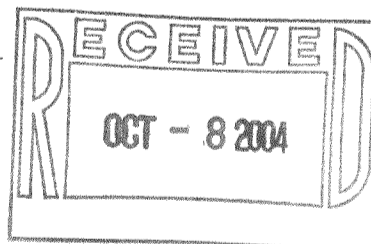

Copyright c 2004 by Jensen & Olson Land Surveying, LLC.

All rights reserved. No part of this survey plat may be reproduced or transmitted in any form by any means - graphic, electronic, or mechanical, including photocopying, tracing, or information storage and retrieval systems - without permission in writing from Douglas G. Olson, Jensen & Olson Land Surveying, LLC.

I hereby certify that I have surveyed the above described property and the map hereon is correct to the best of my professional knowledge and belief and shows the size and location of the property, its exterior boundaries, the location and dimensions of all visible structures thereon, boundary fences, apparent easements and roadways and visible natural features.

This survey is made for the exclusive use of the present owners of property, and also those who purchase, mortgage or guarantee title thereto, within one year from the date hereof.

Douglas G. Olson  
Wisconsin Registered Land Surveyor - 2093

Survey Date: June 28, 2004.  
Revisions:

Scale in Feet  
1" = 20'

**Jensen & Olson Land Surveying, LLC**  
45 South Wisconsin Street P.O. Box 322  
Elkhorn, Wisconsin. 53121  
Telephone (262) 723-3434  
Facsimile (262) 723-8044

**Legend**

- Found Concrete Monument
- ⊗ Found Iron Pipe
- Found Iron Rod
- Recorded Information
- Concrete Cover
- ⊗ Utility Pole
- ▨ Asphalt Surface
- ▨ Concrete Surface
- ▨ Patio Blocks

2004.084	Sheet 1 of 1 Sheets
Job Reference Number <b>2004.084</b>	

ICI 00170

117-2477