
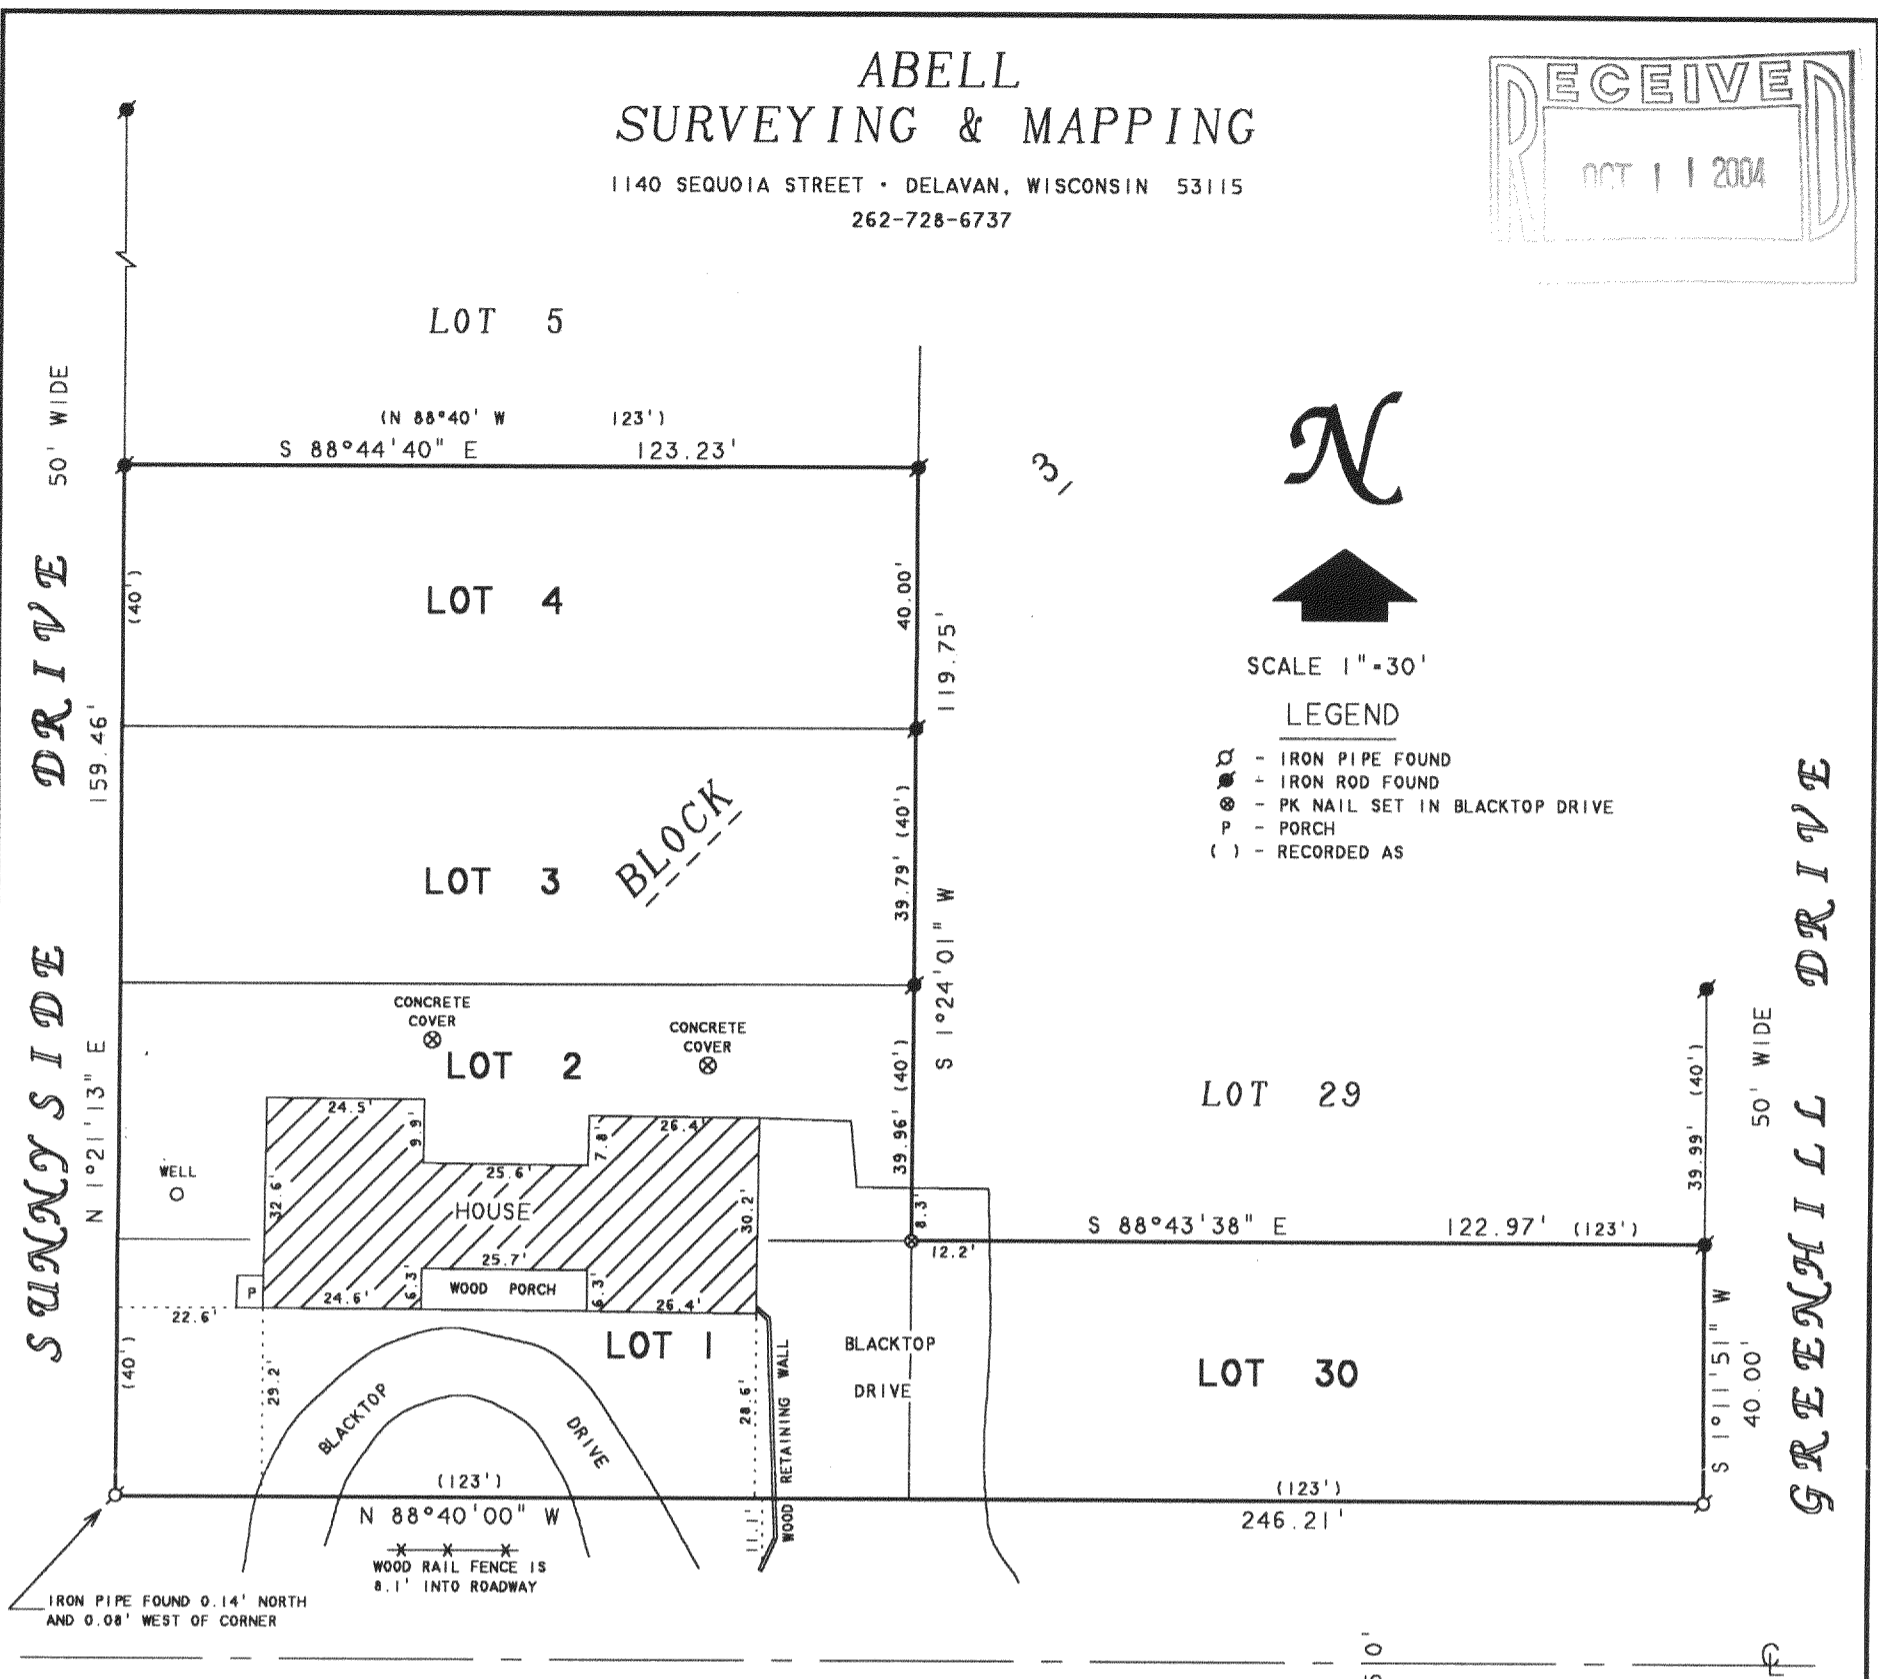


ABELL
SURVEYING & MAPPING

1140 SEQUOIA STREET • DELAVAN, WISCONSIN 53115
262-728-6737

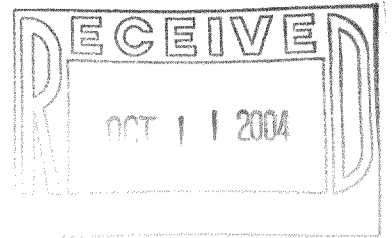

BORDER DRIVE

PLAT OF SURVEY OF

LOTS 1-4 AND LOT 30, BLOCK 3, MAPLE HILLS "A" SUBDIVISION,
LOCATED IN TOWN OF WALWORTH, WISCONSIN, CONTAINING
0.56 ACRES OF LAND MORE OR LESS.

NOTE: BEARINGS ARE REFERENCED TO THE
RECORDED SUBDIVISION PLAT.

ORDERED BY: THE RAULAND AGENCY
P.O. BOX 159
WALWORTH, WI. 53184

I HEREBY CERTIFY THAT I HAVE SURVEYED THE ABOVE DESCRIBED PROPERTY AND THAT THE ABOVE MAP IS A TRUE REPRESENTATION THEREOF AND SHOWS THE SIZE AND LOCATION OF THE PROPERTY, ITS EXTERIOR BOUNDARIES, THE LOCATION OF ALL VISIBLE STRUCTURES AND DIMENSIONS OF ALL PRINCIPAL BUILDINGS THEREON, BOUNDARY FENCES, APPARENT EASEMENTS, ROADWAYS AND VISIBLE ENCROACHMENTS, IF ANY, TO THE BEST OF MY KNOWLEDGE AND BELIEF.

THIS SURVEY IS MADE FOR THE USE OF THE PRESENT OWNERS OF THE PROPERTY, AND ALSO THOSE WHO PURCHASE, MORTGAGE, OR GUARANTEE THE TITLE THERETO WITHIN ONE (1) YEAR FROM DATE HEREON.

David F. Abell

DAVID F. ABELL
WISCONSIN REGISTERED LAND SURVEYOR, S-1596

REVISED AND RECERTIFIED MAY 10, 2004
ORDERED BY: COLDWELL BANKER-PRIMUS REALTY
226 BROAD STREET
LAKE GENEVA, WI 53147

May 18, 1993

DATE: May 18, 1993 JOB NUMBER - 93096A
NOTE: THIS IS NOT A CERTIFIED COPY UNLESS SEALED.

IMH 00039 & IMH 00061

117-2482