PREPARED FOR: BEVERLY AND ROBERT HAMMERSCHMIDT


890 PINEGROVE CT. WHEATON IL. 60187


PLAT OF SURVEY

J.K. SURVEYING INC. N3705 WILLOWBEND LANE LAKE GENEVA, WI, 53147 262-248-3697

- OF -

LOT 129 AND THE EAST 58 FEET OF LOT 132 IN THE SUBDIVISION KNOWN AS LAKE GENEVA BEACH, LOCATED IN SECTION 11 TOWN 1 NORTH, RANGE 17 EAST, WALWORTH COUNTY, WISCONSIN.

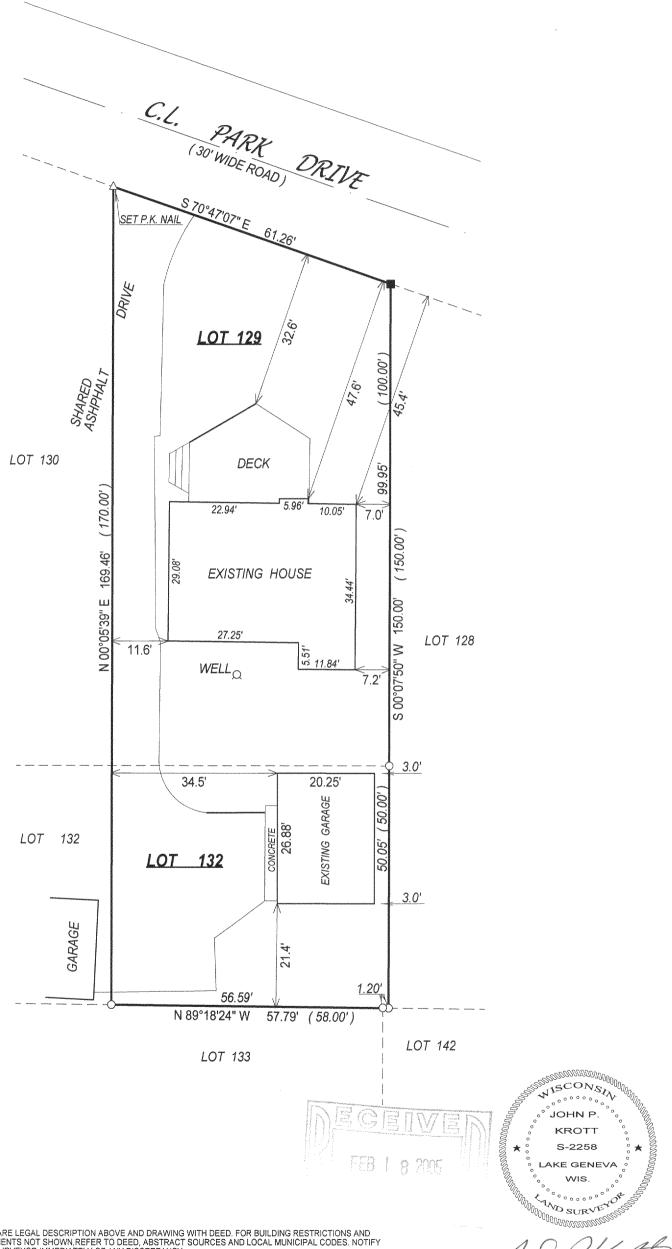

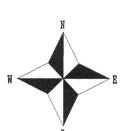

()= recorded as

= found iron bar

= found iron pipe

= set iron pipe

= set iron bar

SCALE 1" = 20'

JOB # 04-544

TAX ID # ILGB00118

COMPARE LEGAL DESCRIPTION ABOVE AND DRAWING WITH DEED. FOR BUILDING RESTRICTIONS AND EASEMENTS NOT SHOWN, REFER TO DEED, ABSTRACT SOURCES AND LOCAL MUNICIPAL CODES. NOTIFY THE SURVEYOR IMMEDIATELY OF ANY DISCREPANCY.

"I hereby certify that I have surveyed the above described property and that the above map, to the best of my knowledge and belief, is a true representation thereof and shows the size and location of all visible structures, apparent easements and encroachmentsif any."

This survey is made for the present owners of the property, and those who purchase, mortgage, or guarentee the title thereto, within one year from the date hereof.

JOHN KROTT S - 2258 Wisconsin Registered Land Surveyor (original if signed in red)

DATED THIS THE 6th DAY OF OCTOBER 2004.