


PLAT OF SURVEY

Survey No. 5678-B

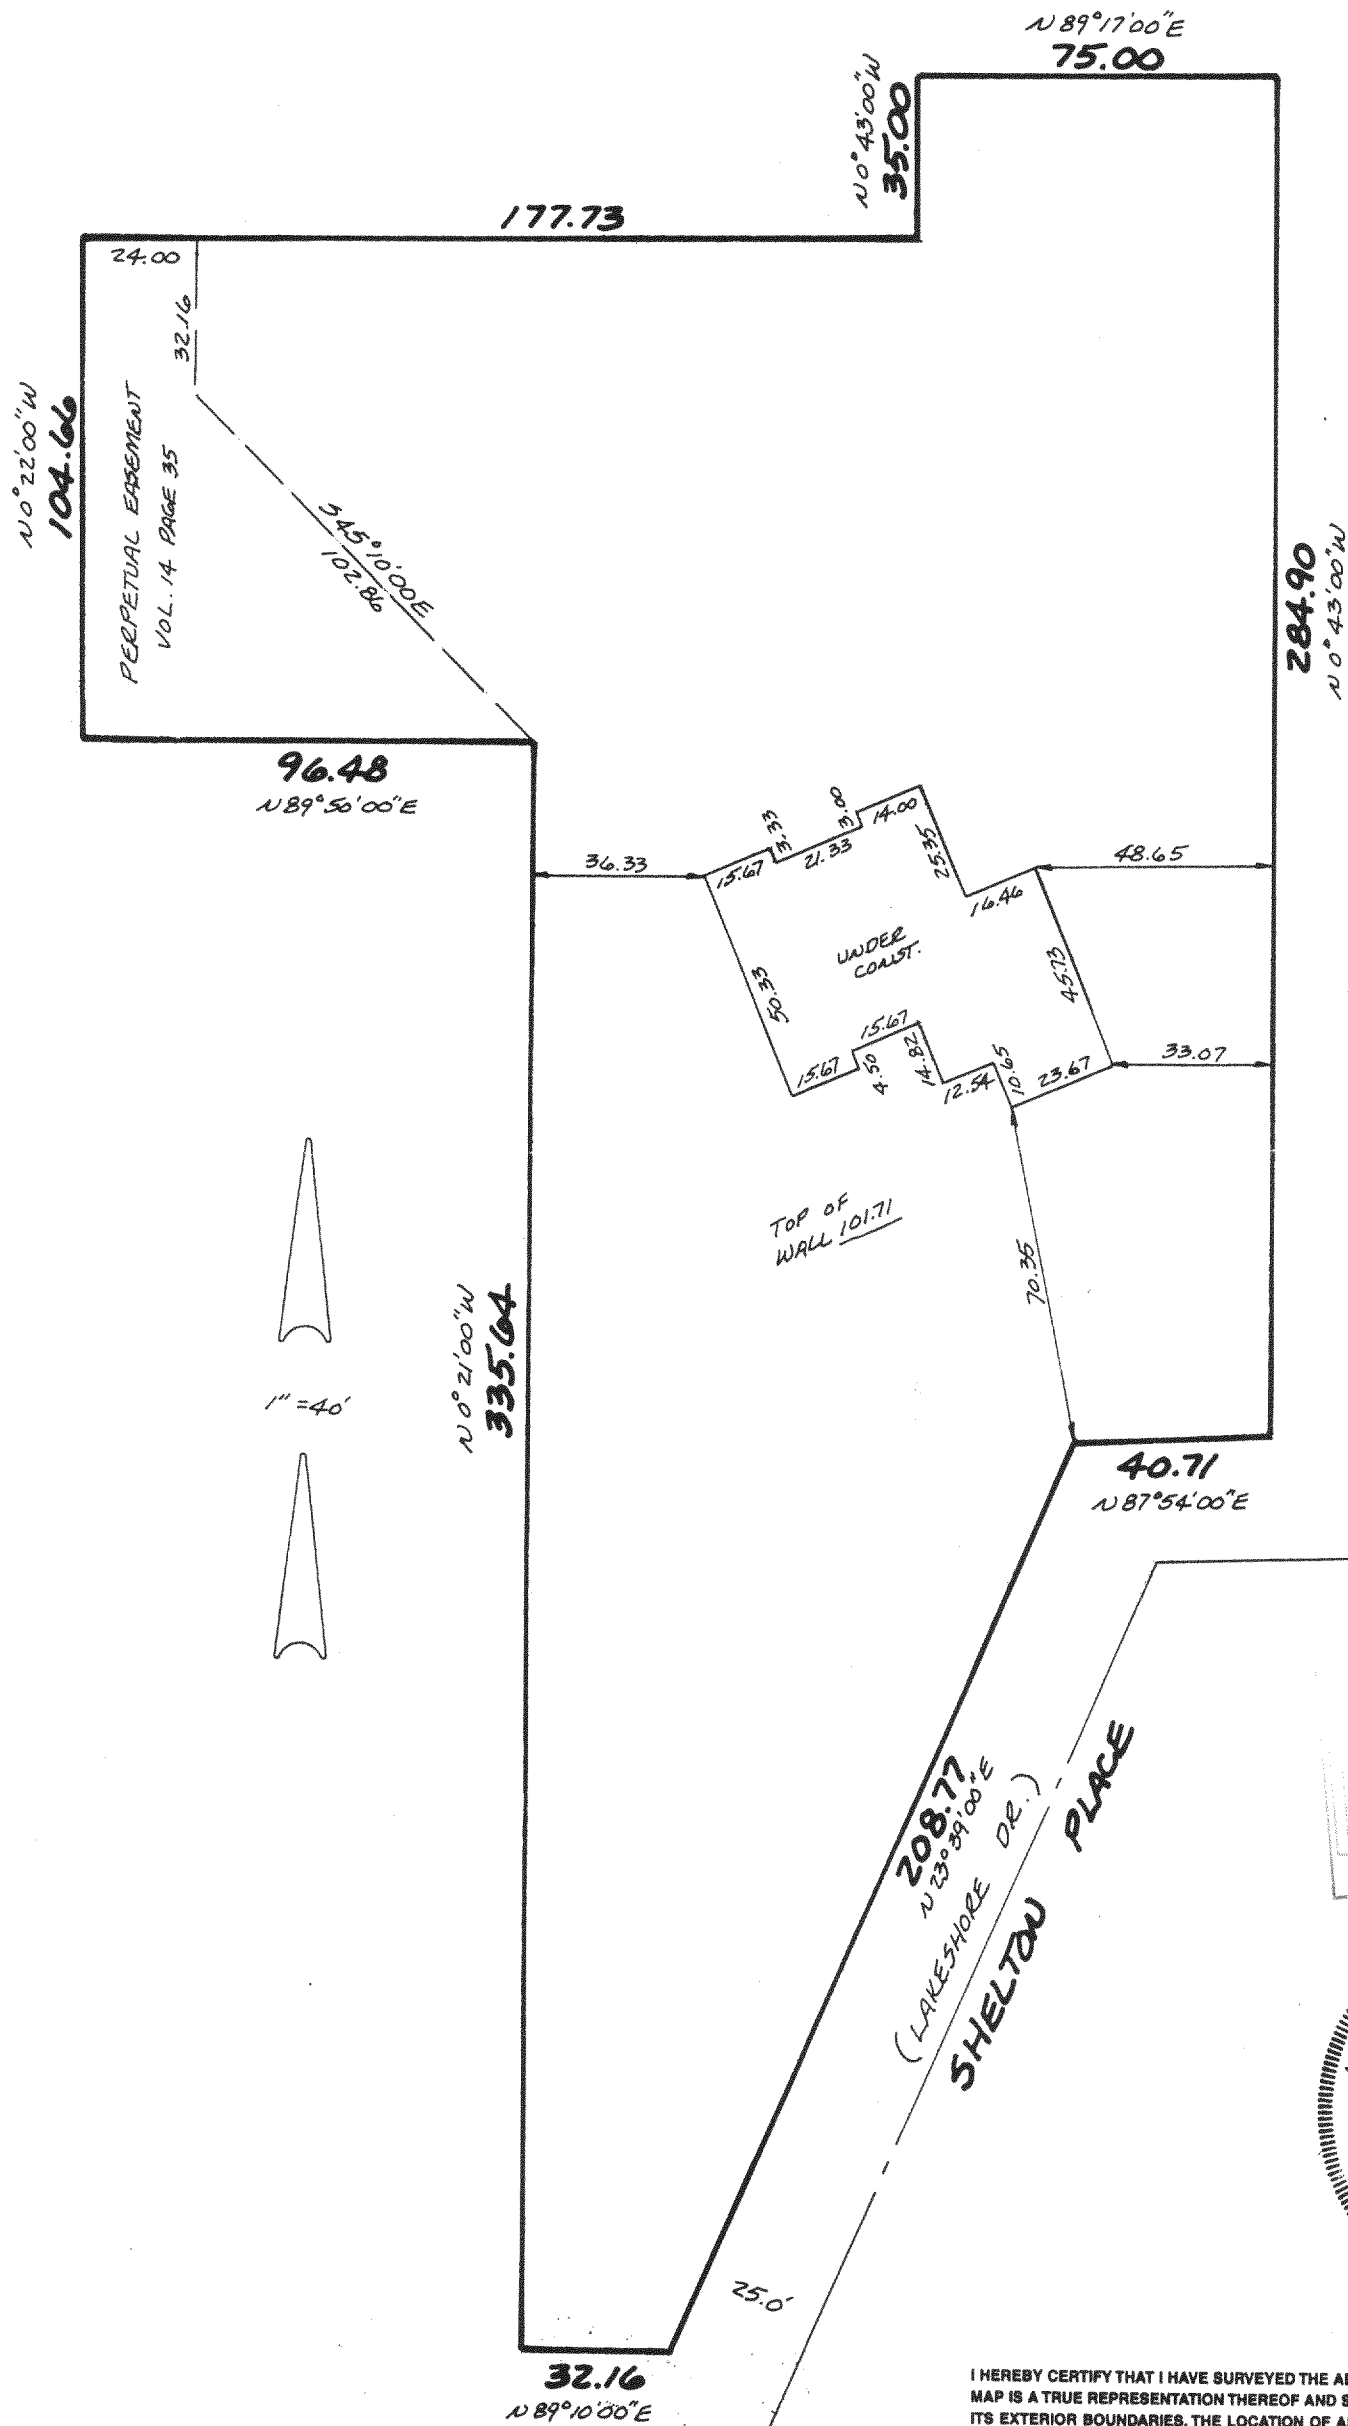

SIGNED

Rayne D. Michelson

Wayne D. Mickelson
Registered Land Surveyor S-1349

117-25817