




SCALE 1"=20'
○-IRON PIPE
●-CONC. MONU.

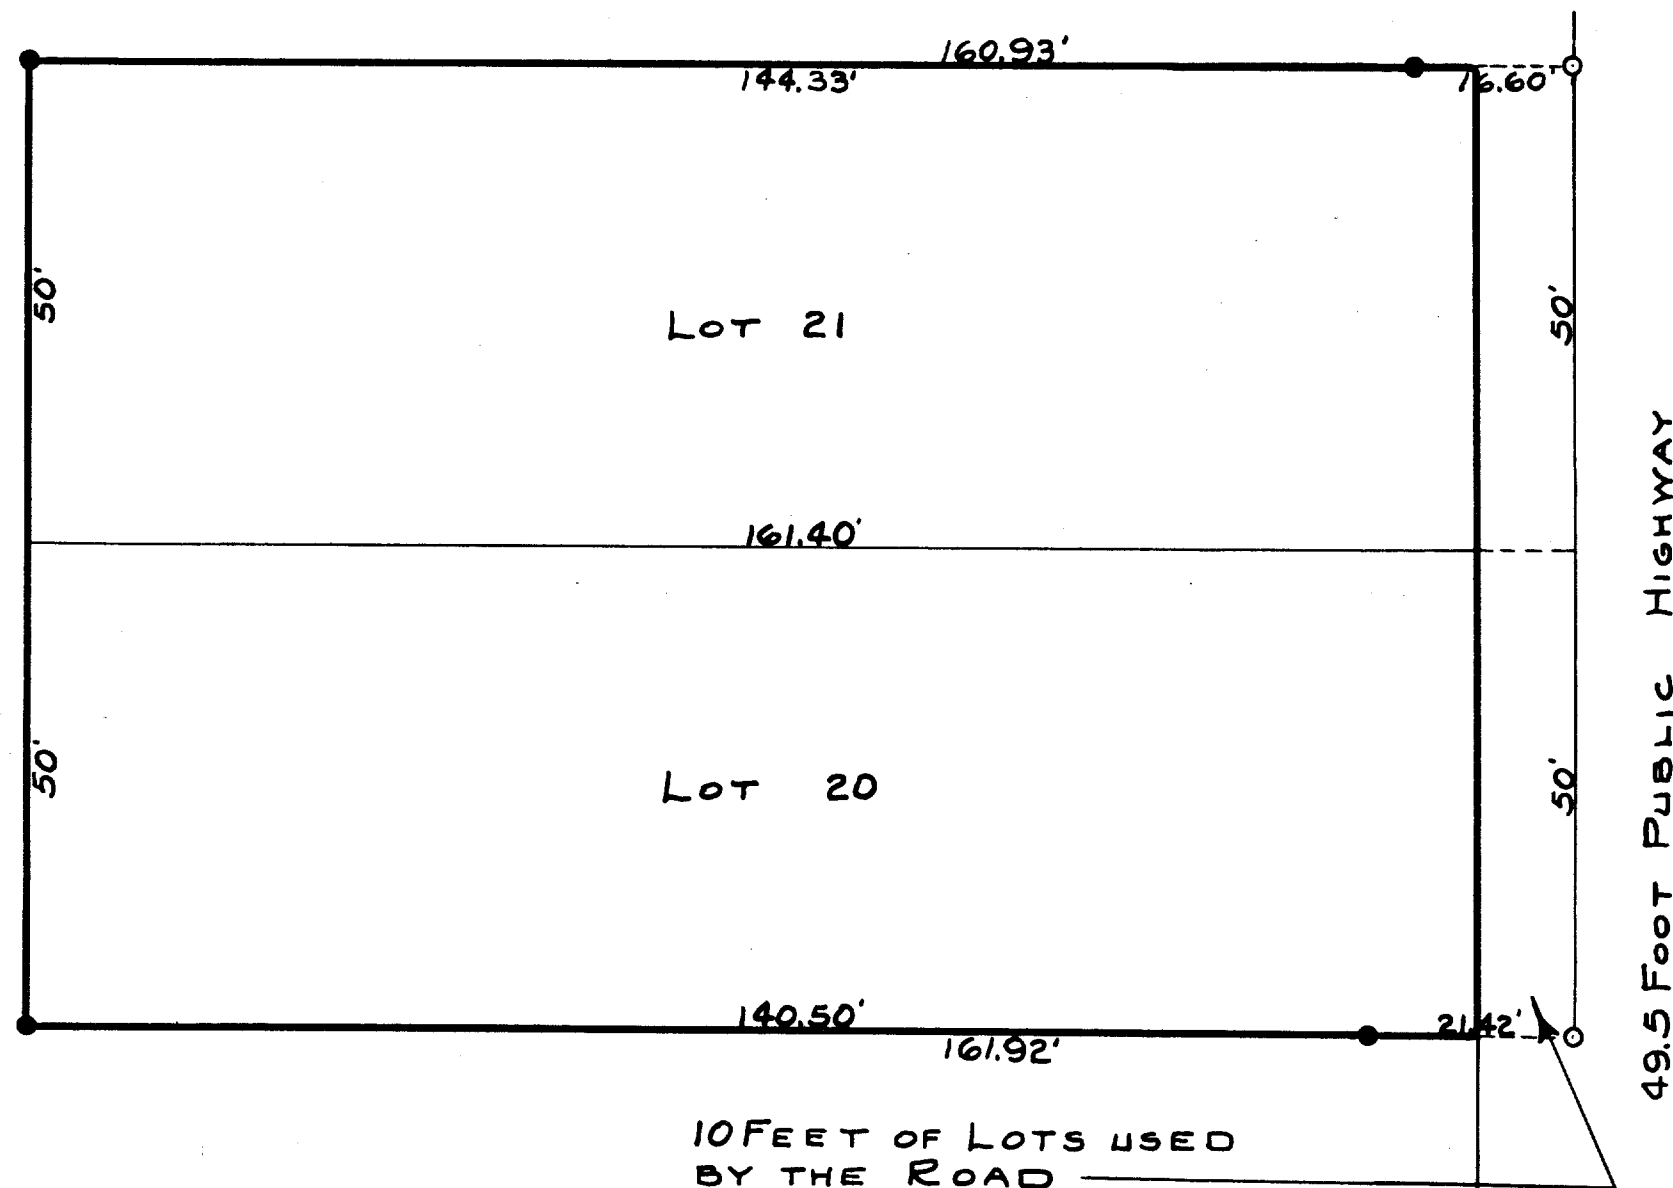

PLAT OF SURVEY OF LOTS 20 AND 21 OF LAKE
GENEVA BEACH SUBDIVISION, LOCATED IN
SECTION 11, T1N R17E OF WALWORTH COUNTY
WISCONSIN.

AUG. 2, 1944

Lloyd L. Jensen
COUNTY SURVEYOR