
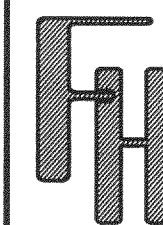


PLAT OF SURVEY

BUILDING PERMIT PLAT

UNIT 2
SOUTH SHORE CLUB ON LAKE GENEVA
A CONDOMINIUM
REC. IN CAB. A, SLIDE 394, DOC. NO. 500527

LOCATED IN CERTIFIED SURVEY MAP 2631
RECORDED IN VOL. 13 OF CERTIFIED SURVEYS
ON PAGE 171, AS DOCUMENT NUMBER 311927
BEING IN ALL 1/4'S OF NE 1/4 OF
SECTION 18, TOWN 1 NORTH, RANGE 17 EAST
WALWORTH COUNTY, WISCONSIN

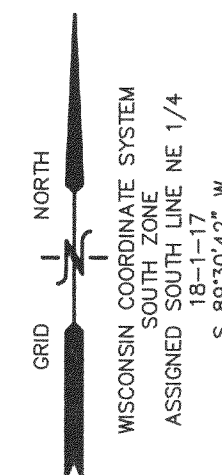

WORK ORDERED BY —
TOM COWAN — GENE DARFLER, INC.
506 EAST HIGHLAND AVENUE
NAPERVILLE, IL 60540

FARRIS, HANSEN & ASSOCIATES, INC.
ENGINEERING — ARCHITECTURE — SURVEYING
7 RIDGWAY COURT P.O. BOX 437
ELKHORN, WISCONSIN 53121
OFFICE: (262) 723-2098 FAX: (262) 723-5886

REVISIONS
09/14/2005
SITE, GRADING,
DRAINAGE, &
EROSION
CONTROL PLAN
11/09/2005
TO SHOW SIZE
AND LOCATION
OF AS-BUILT
FOUNDATION

PROJECT NO.
4161.02
DATE:
08/10/05
SHEET NO.
1 OF 1

- LEGEND
- XXX = EXISTING CONTOURS
 - XXX = PROPOSED CONTOURS
 - = TREE TO BE REMOVED
 - F.F. = FIRST FLOOR ELEVATION
 - T.F. = TOP OF FOUNDATION ELEVATION
 - G.E. = GARAGE ENTRY ELEVATION
 - BASE = BASEMENT ELEVEMENT

RIM=922.5

FOREST HILLS COURT

RIM=922.5

RIM=923.4

UNIT 3

FUTURE FIRST FLOOR
GRADE=928.5'

FOUNDATION ON
UNIT BOUNDARY

FOUNDATION ON
UNIT BOUNDARY

EXTG. BEEHIVE
CATCH BASIN
RIM=915.5'

CONCRETE
SLABS

FOUNDATION ON
UNIT BOUNDARY

FUTURE FIRST FLOOR
GRADE=933.2'

UNIT 1

FOUNDATION ON
UNIT BOUNDARY

AS-BUILT FOUNDATION
T.F.=927.9'


FOUNDATION ON
UNIT BOUNDARY

28" MAPLE

36" MAPLE

TRANS
CAT

FOREST HILLS LANE

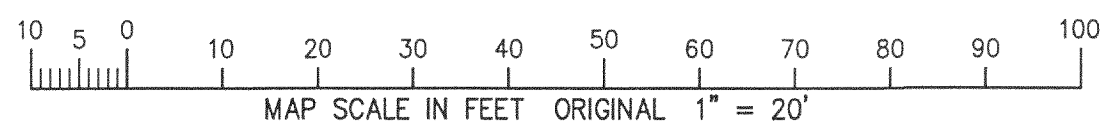

NOTE: COPIES OF THIS MAP TO WHICH THE FOLLOWING CERTIFICATE WILL APPLY SHOW
SURVEYOR'S ORIGINAL SEAL AND SIGNATURE IN RED INK. COPIES BY ANY OTHER MEANS
MAY HAVE ALTERATIONS WHICH DO NOT REPRESENT THE SURVEYOR'S WORK PRODUCT.


I HEREBY CERTIFY THAT THE ABOVE DESCRIBED PROPERTY HAS BEEN SURVEYED UNDER MY
DIRECTION AND THAT THE ABOVE MAP IS A TRUE REPRESENTATION THEREOF AND SHOWS THE
SIZE AND LOCATION OF THE PROPERTY AND ITS EXTERIOR BOUNDARIES. THIS SURVEY IS
MADE FOR THE USE OF THE PRESENT OWNERS OF THE PROPERTY, AND ALSO THOSE WHO
PURCHASE, MORTGAGE, OR GUARANTEE THE TITLE THERETO WITHIN ONE YEAR FROM THE DATE
HEREOF.

DATED: AUGUST 10, 2005

REVISED 10-03-2005

REVISED 11-09-2005
TO SHOW SIZE & LOCATION OF
AS BUILT FOUNDATION

PETER S. GORDON R.L.S. 2101

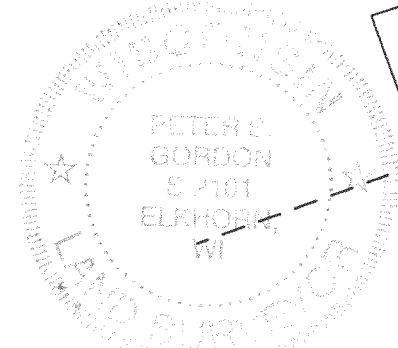

15SC-2

117-2618