

■ = set iron bar

JOB # 05-479

TAX KEY # ILGB00061

OF

LOT 71

LOT 72

LOT 70

LOT 69

LOT 68

OVER HEAD UTILITIES ALONG LINE

NOTE: CREEK FLOWS ALONG LOT LINE

N 00°22'49" W 49.79' (50.00')

14.5'

8.1'

8.8'

9.8'

SHED

VENT

CONCRETE LID

DECK

EXISTING HOUSE

32.4'

32.2'

28.4'

9.3'

98.62'

13.78'

N 89°46'15" W 112.40' (112.50')

12.1'

20.0'

28.3'

9.6'

WELL

3000'

ASHALT DRIVE

S 89°50'51" E 112.73' (112.50')

S 00°00'00" E 49.93' (50.00')


49.94'

WEST BEACH DRIVE

(25' WIDE ROAD)

This survey is made for the present owners of the property, and those who purchase, mortgage, or guarantee the title thereto, within one year from the date hereof.

RECEIVED
DEC 14 2005
SMF

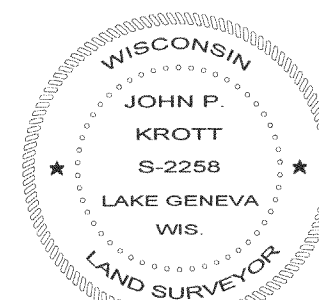



JOHN KROTT S - 2258
Wisconsin Registered Land Surveyor
(original if signed in red)

DATED THIS THE 14th DAY OF SEPTEMBER 2005.

ILGB-101

117-2628