


PATHFINDER SURVEYING INC.  
N3705 WILLOW BEND LANE  
LAKE GENEVA WI. 53147

# PLAT OF SURVEY

- OF -

LOTS 4 AND 5 BLOCK 1, OF KUEBKER ADDITION  
TO THE VILLAGE OF ZENDA, WALWORTH COUNTY,  
WISCONSIN.

PREPARED FOR: PEARL HEINRICH  
PO. BOX 37  
ZENDA WI. 53195

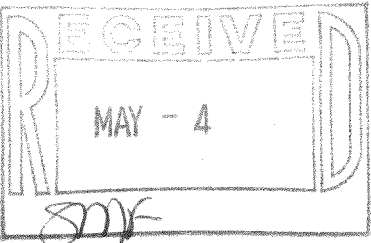


DATE OF LAST REVISION: 1 / 12 / 2006

*John P. Krott*

JOHN KROTT S - 2258  
Wisconsin Registered Land Surveyor  
( original if signed in red )

DATED THIS THE 29th DAY OF NOVEMBER 2005.

C.L. PLEASANT STREET  
( 60' WIDE ROAD PLATTED AS ZENDA STREET )

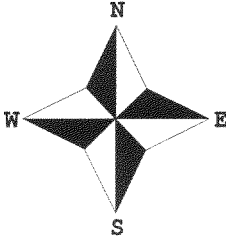

- ( ) = recorded as
- = found iron bar
- = found iron pipe
- = set iron pipe
- = set iron bar


SCALE 1" = 20'

JOB # 05-615AB

TAX ID # IZK00001AA & 1A

COMPARE LEGAL DESCRIPTION ABOVE AND DRAWING WITH DEED. FOR BUILDING RESTRICTIONS AND EASEMENTS NOT SHOWN, REFER TO DEED, ABSTRACT SOURCES AND LOCAL MUNICIPAL CODES. NOTIFY THE SURVEYOR IMMEDIATELY OF ANY DISCREPANCY.

"I hereby certify that I have surveyed the above described property and that the above map, to the best of my knowledge and belief, is a true representation thereof and shows the size and location of all visible structures, apparent easements and encroachments if any."  
This survey is made for the present owners of the property, and those who purchase, mortgage, or guarantee the title thereto, within one year from the date hereof.

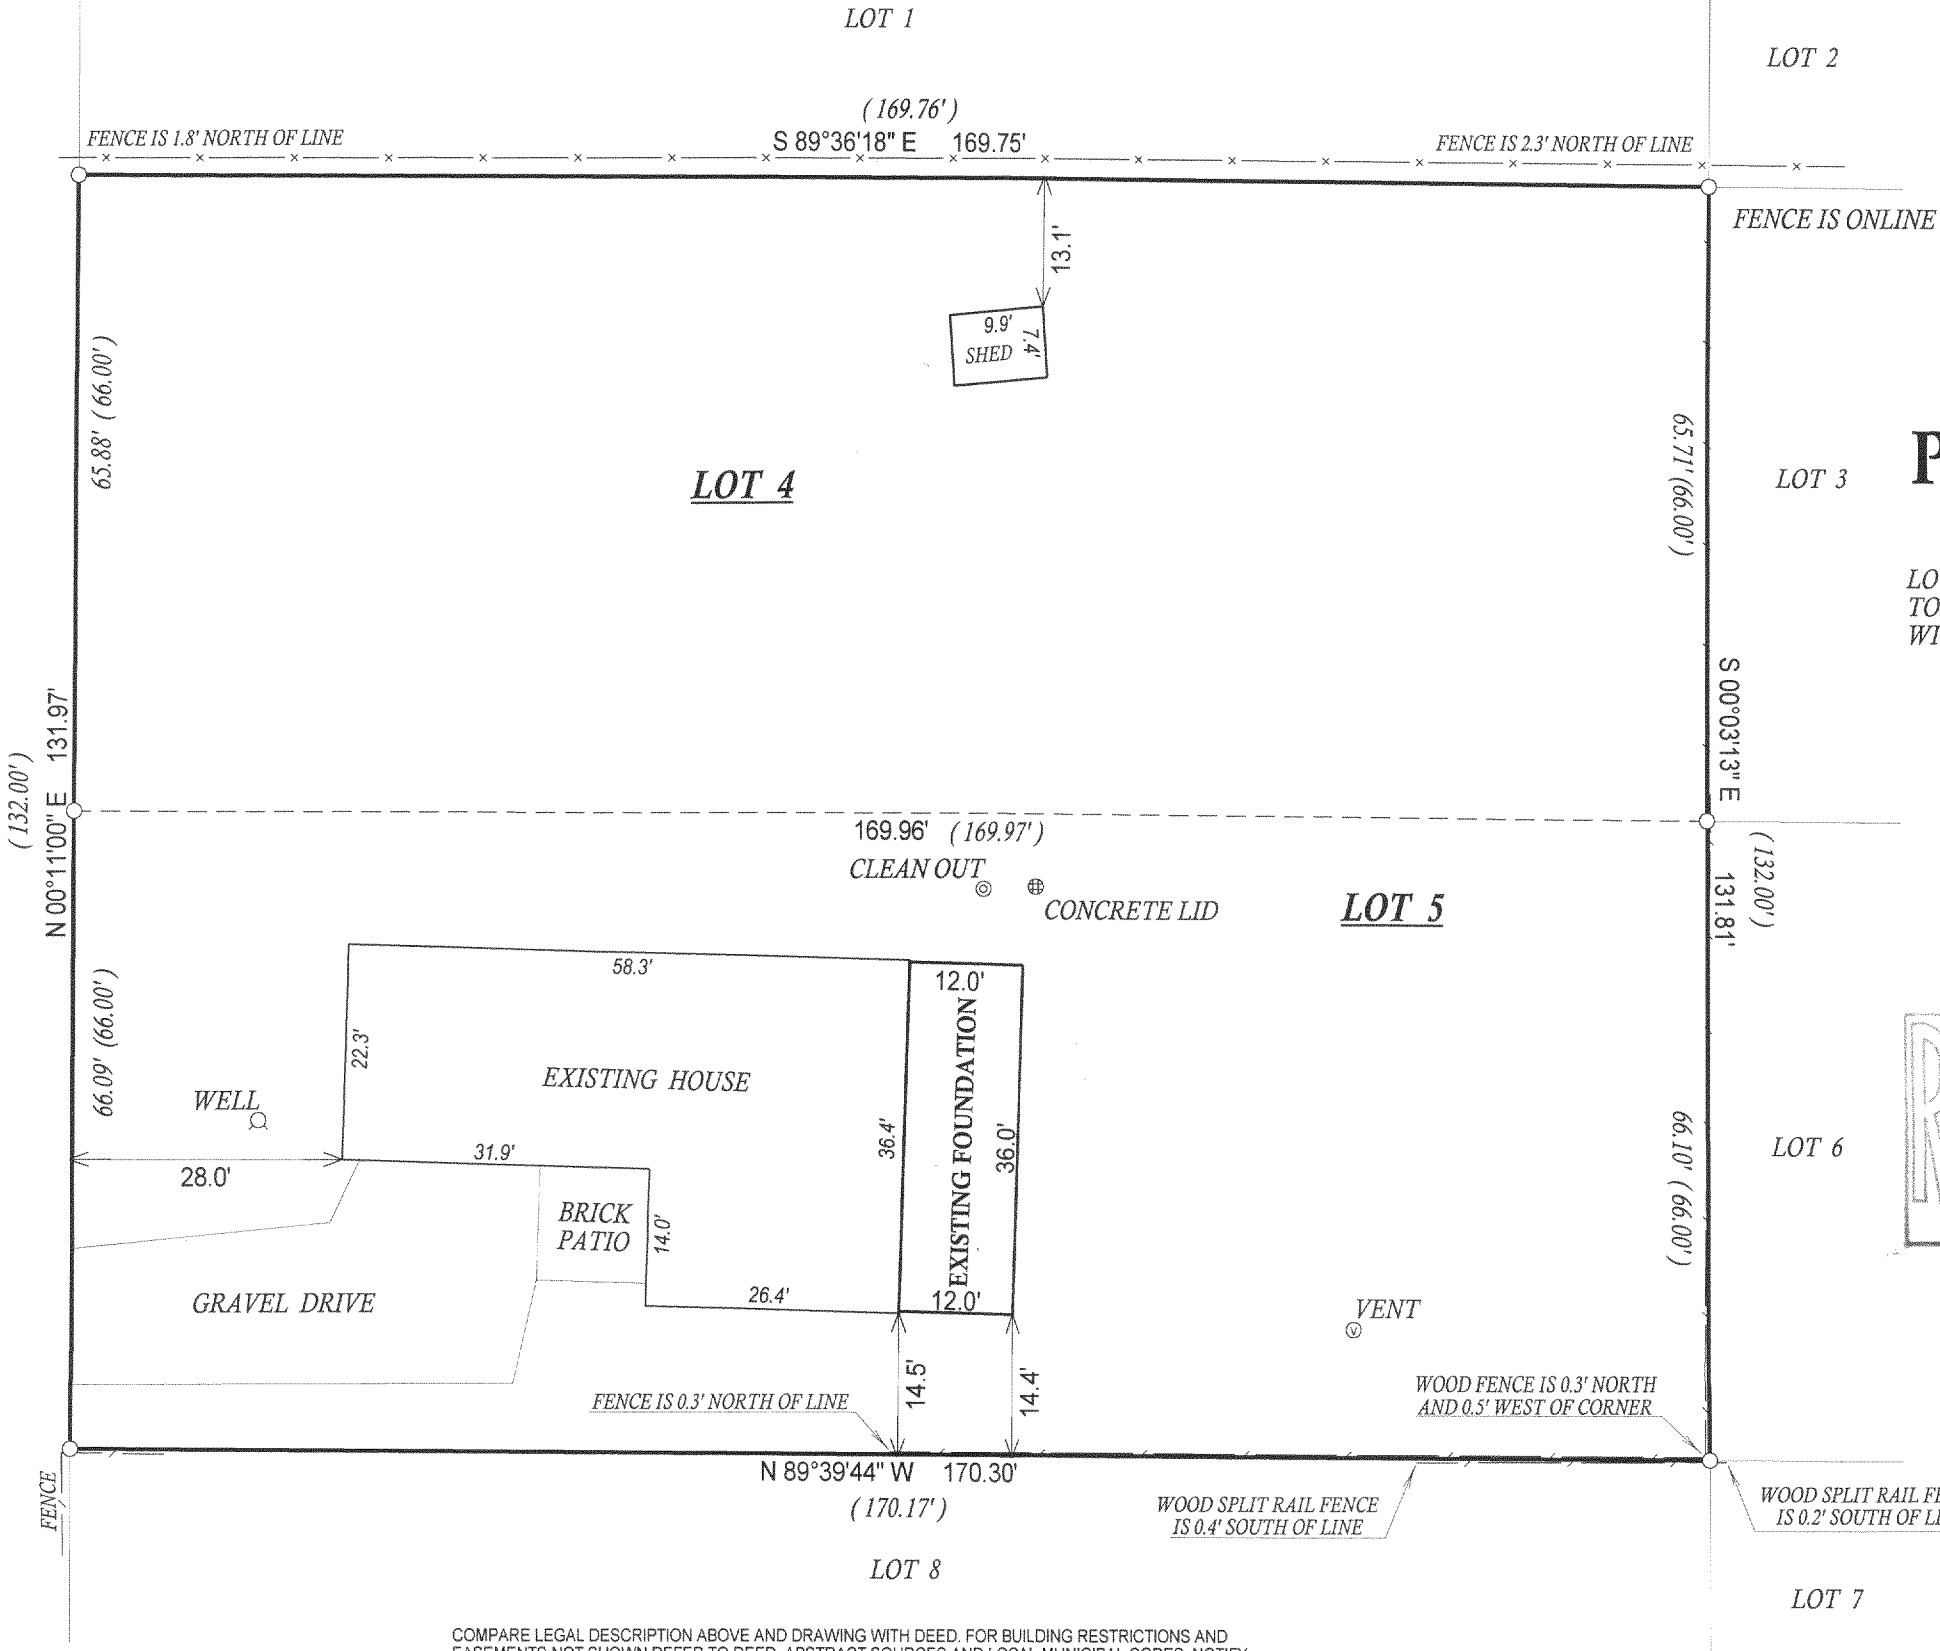

IZK-1A IZK-1AA

117-2679