


PLAT OF SURVEY

OF

LOTS 67 & 68 LAKE GENEVA BEACH SUBDIVISION,
LOCATED IN SW $\frac{1}{4}$ OF SECTION 11, T1N R1E, WALWORTH
COUNTY, WISCONSIN.

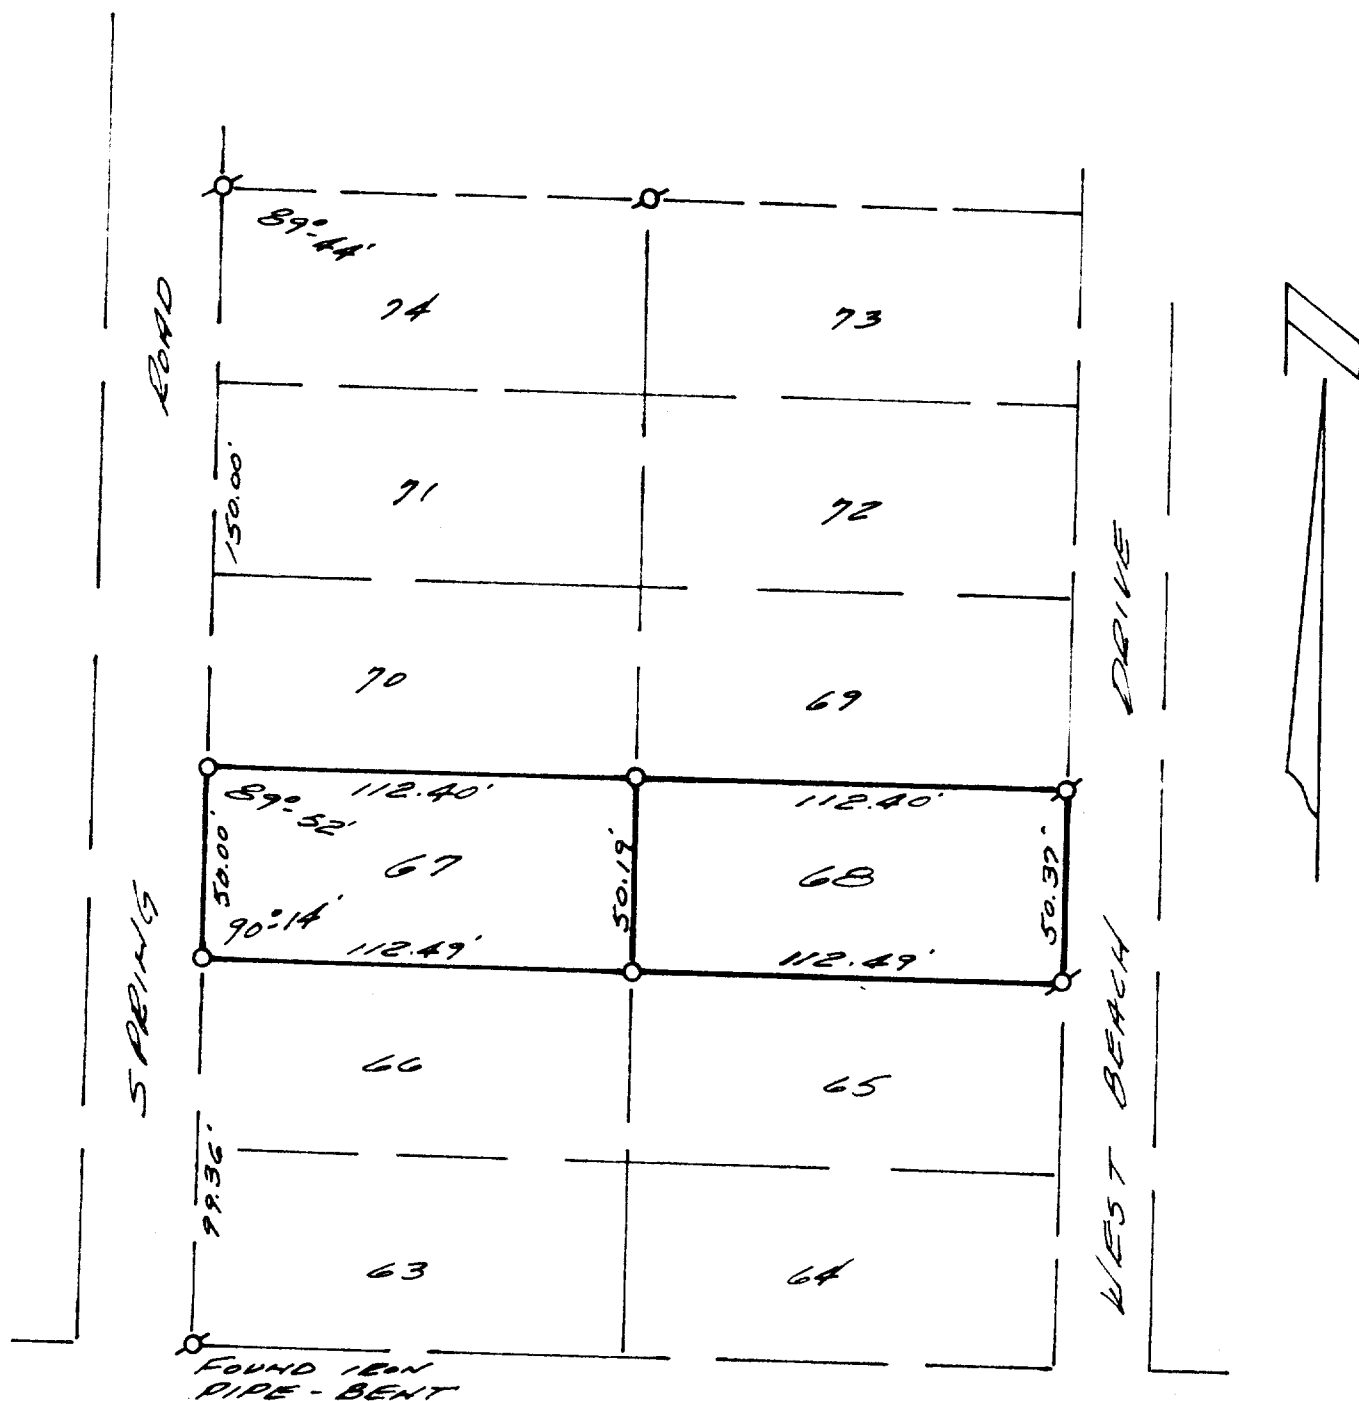

SURVEY AND PLAT BY

JENSEN & JOHNSON, INC.

CIVIL ENGINEERS AND SURVEYORS

Elkhorn, Wisconsin

LEGEND

- — Iron Pipe SET
- — Concrete Monument

Scale 1" = 50'

○ — IRON PIPE FOUND

WE CERTIFY: That we have surveyed the above described property and that the plat shown hereon is an accurate survey and a true representation thereof and correctly shows the exterior boundary lines and all divisions of said property.

Date JAN 1972

Lloyd L. Jensen

LLOYD L. JENSEN,

Wisconsin Registered Land Surveyor, No. S-211

716B-59+60