


LOT 2  
C.S.M. 3662

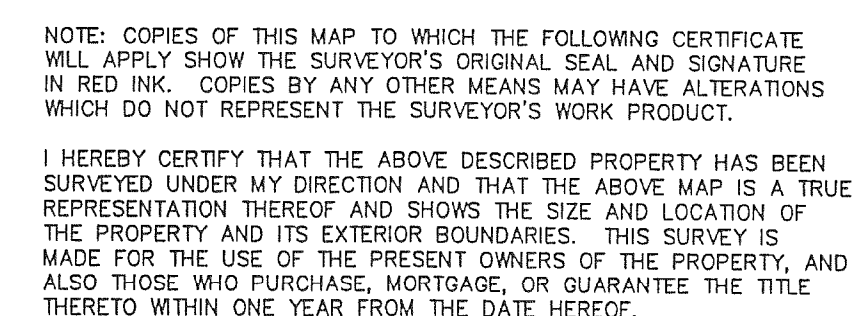

DATED: JUNE 16, 2005

PETER S. GORDON RLS 2101

PETER S. GORDON R.L.S. 2101

— WORK ORDERED BY —  
SHANNON LASSITER — ORREN PICKELL DESIGN GROUP  
200 TRI-STATE INTERNATIONAL, SUITE 200  
LINCOLNSHIRE, IL 60069

---

---

FARRIS, HANSEN & ASSOCIATES, INC.

ENGINEERING - ARCHITECTURE - SURVEYING

7 RIDGWAY COURT P.O. BOX 437  
ELKHORN, WISCONSIN 53121

OFFICE: (262) 723-2098 FAX: (262) 723-5886  
CENTON, WISCONSIN 53121

## REVISIONS

07/28/2005  
SITE, GRADING,  
DRAINAGE, & EROSION  
CONTROL PLAN  
01/25/2006  
ADD SEPTIC FIELD  
AND ADJUST DRIVEWAY  
MISC. REVISIONS  
04/03/2006  
TO SHOW SIZE AND  
LOCATION OF AS-BUILT  
FOUNDATION

PROJECT NO.

6384 05

DATE \_\_\_\_\_

06/16/05

00/10/00
----------

SHEET NO. 1 OF 1

1 OF 1

2