

# LAND-MARK SURVEYING

Mark L. Miritz

Wisconsin Registered Land Surveyor S-2582



N9330 Knuteson Drive  
Whitewater, WI 53190  
Phone: (262) 495-3284  
FAX: (262) 495-8421  
LAND-MARKSURVEYING.COM

OWNER: PATRICIA M. HUGAR TRUST  
1316 WILLIAM ST.  
RIVER FOREST, IL. 60305

## PLAT OF SURVEY

PART OF LOT 14, BLOCK 2 OF WOODDALE ADDITION,  
TOWN 1 NORTH, RANGE 17 EAST, LINN TOWNSHIP,  
WALWORTH COUNTY, WISCONSIN AS DESCRIBED IN  
VOL. 660, PAGE 9291, DOC. NO. 405506 OF RECORDS,  
WALWORTH COUNTY, WISCONSIN.

ORDERED BY: SCHAUDER HOMES  
6326 1ST AVE.  
LAKE GENEVA, WI. 53147  
(262) 248-1088

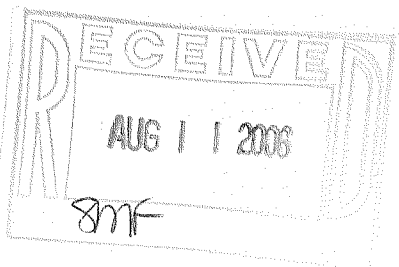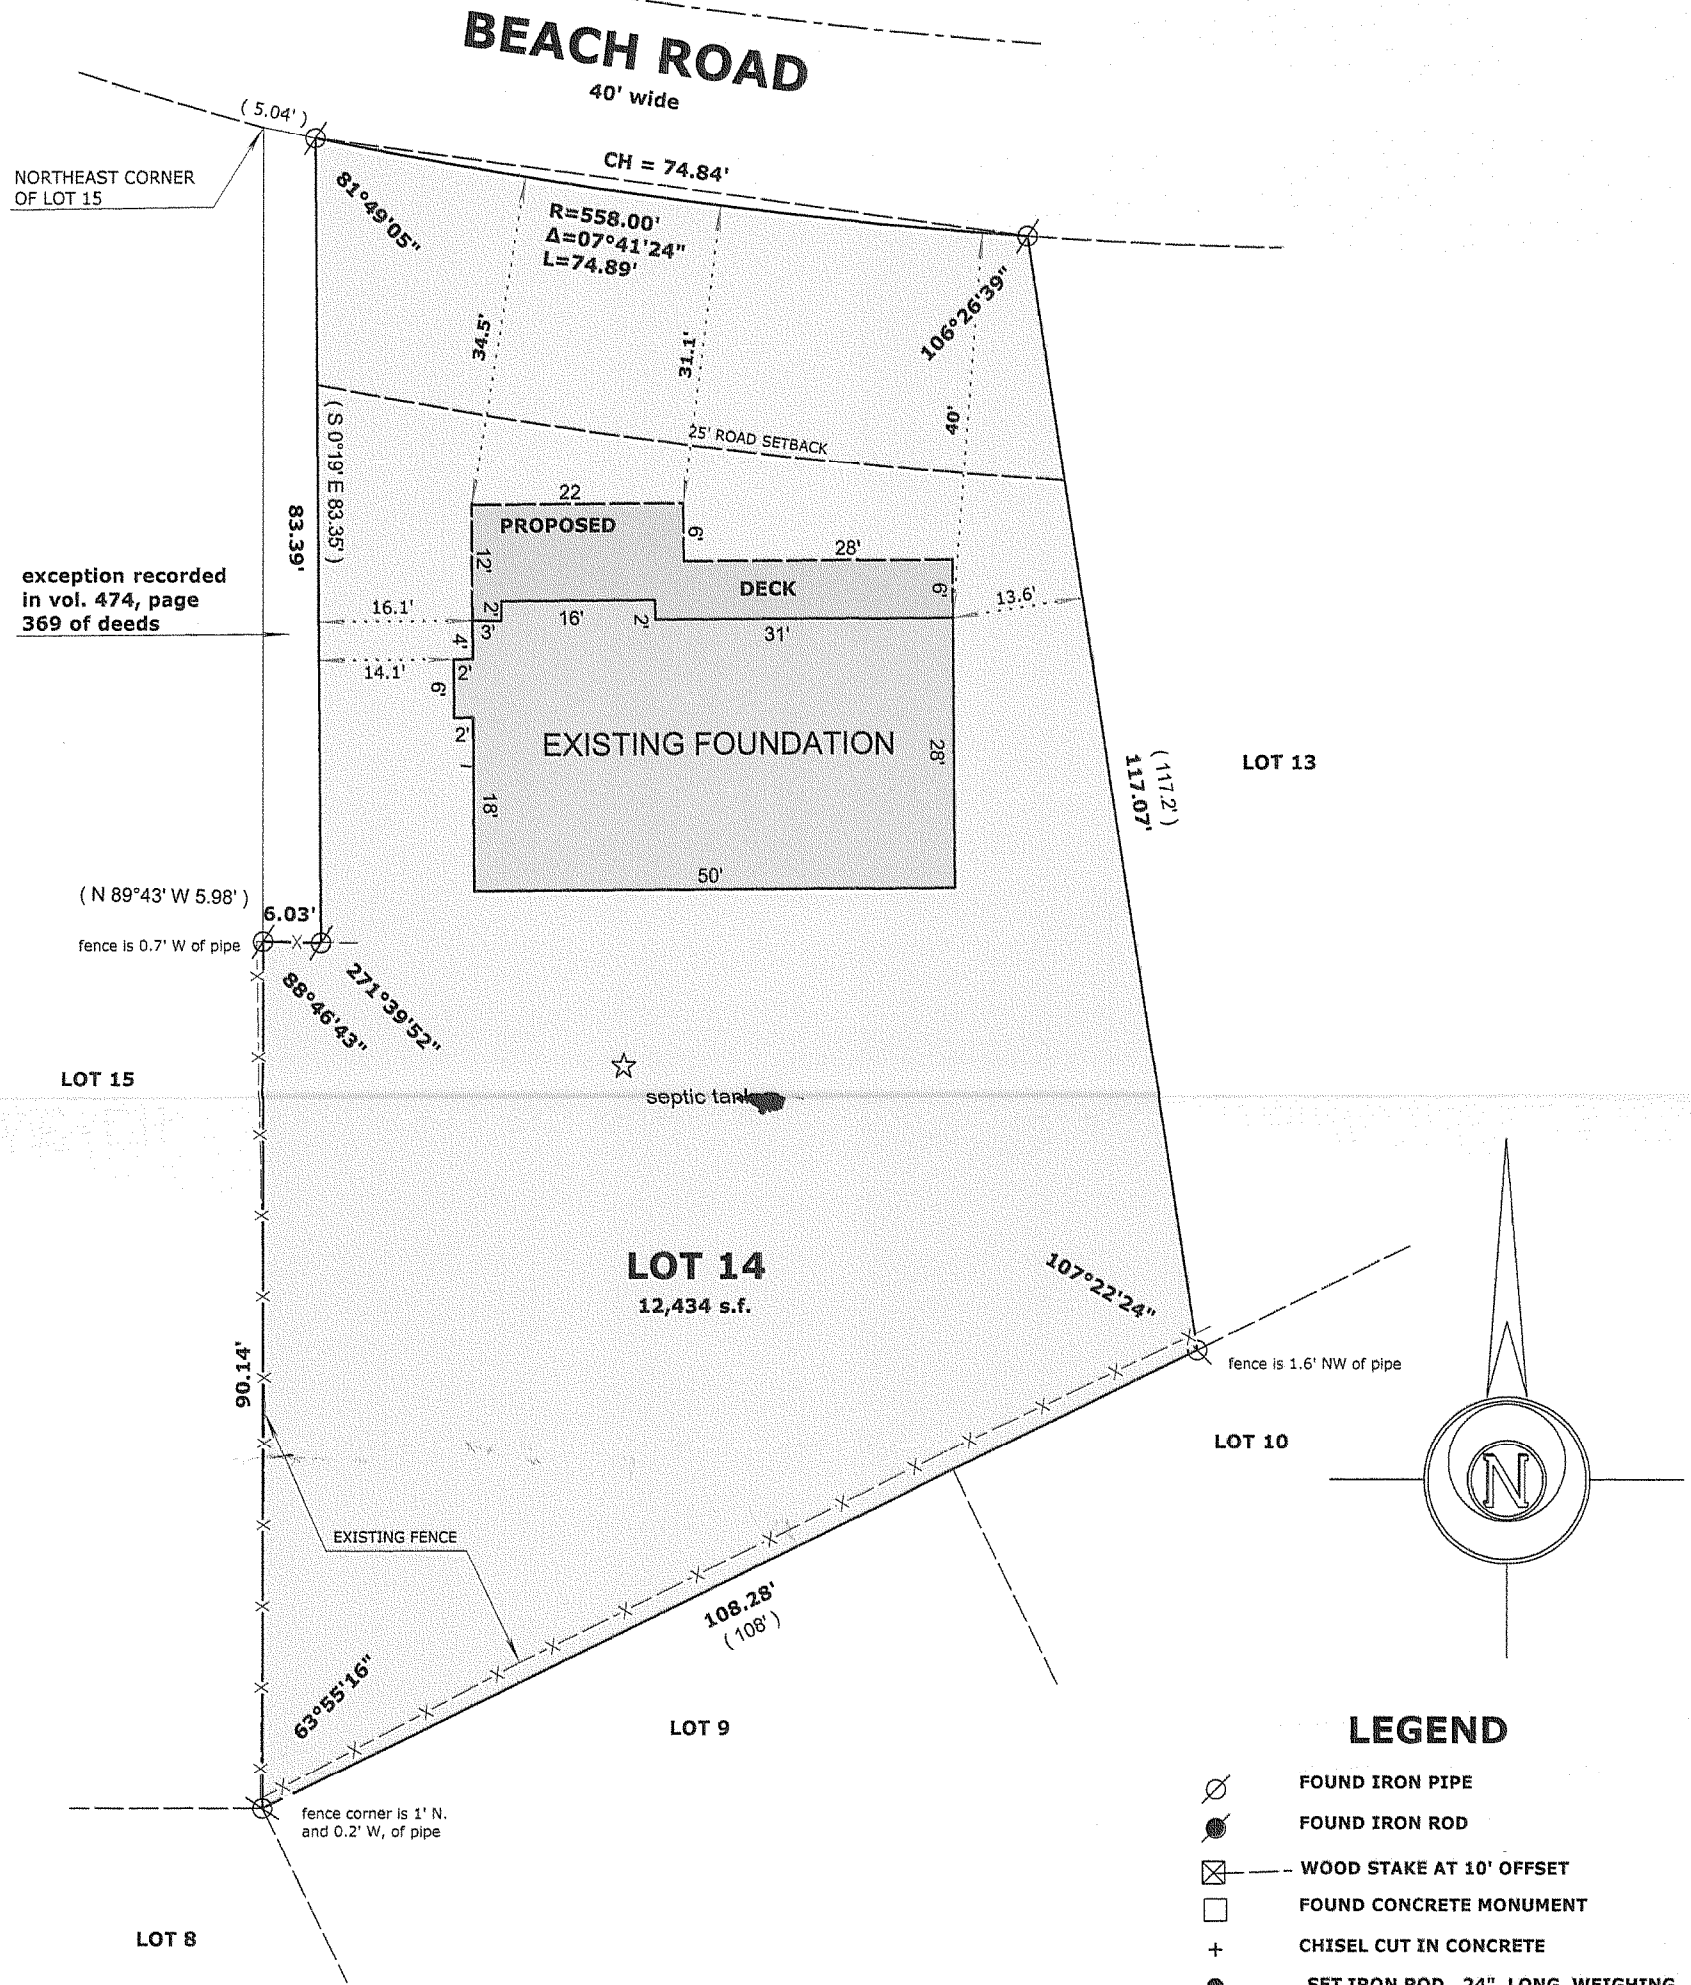

MARK L. MIRITZ  
WISCONSIN REGISTERED  
LAND SURVEYOR S-2582

REVISED JUNE 24, 2006 TO  
SHOW FOUNDATION "AS BUILT"

DATE: DEC. 27, 2005 JOB NO. 05.1205

IW-27

117-2710