
PLAT OF SURVEY

PATHFINDER SURVEYING INC. W2888 KRUEGER RD. UNIT "D" LAKE GENEVA WI. 53147 (262) 248-3697

- OF -

LOTS 40 THRU 43 AND LOTS 53 THRU 57 EDGEWATER WATER TERRACE SUBDIVISION LOCATED IN TOWN 1 NORTH, RANGE 17 EAST, WALWORTH COUNTY, WISCONSIN.



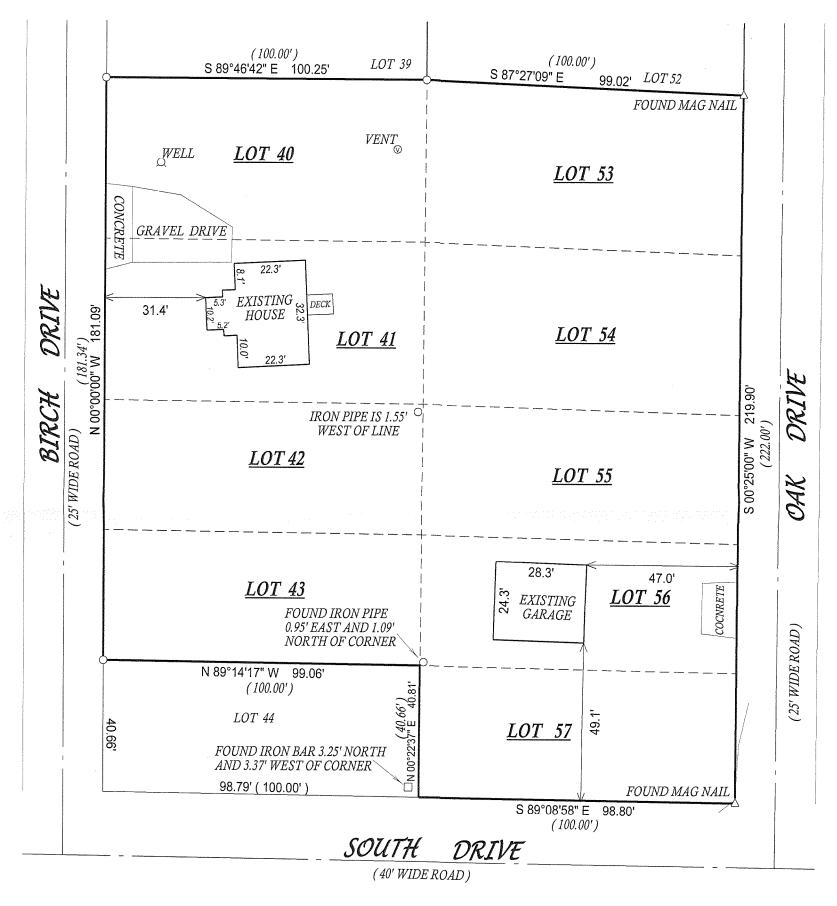

()= recorded as

 \Box = found iron bar

= found iron pipe

= set iron pipe

= set iron bar

SCALE 1" = 30'

JOB # 06-385

TAX ID # IE00036-39 & IE00051-53

COMPARE LEGAL DESCRIPTION ABOVE AND DRAWING WITH DEED. FOR BUILDING RESTRICTIONS AND EASEMENTS NOT SHOWN, REFER TO DEED, ABSTRACT SOURCES AND LOCAL MUNICIPAL CODES. NOTIFY THE SURVEYOR IMMEDIATELY OF ANY DISCREPANCY.

"I hereby certify that I have surveyed the above described property and that the above map, to the best of my knowledge and belief, is a true representation thereof and shows the size and location of all visible structures, apparent easements and encroachments fany."

This survey is made for the present owners of the property, and those who purchase, mortgage, or guarentee the title thereto, within one year from the date hereof.



JOHN KROTT S - 2258
Wisconsin Registered Land Surveyor
(original if signed in red)
DATED THIS THE 6th DAY OF OCTOBER 2005.

117-2733