
Plat of Survey

Lot 1 of Certified Survey Map No. 1417,

recorded in Vol. 6 of Certified Survey Maps of Walworth County on Page 296 and located in the Southwest 1/4 of Section 17, Town 1 North, Range 17 East, Town of Linn, Walworth County,

Surveyed for: Sheldon Landscaping P.O. Box 169 Fontana, Wisconsin. 53125

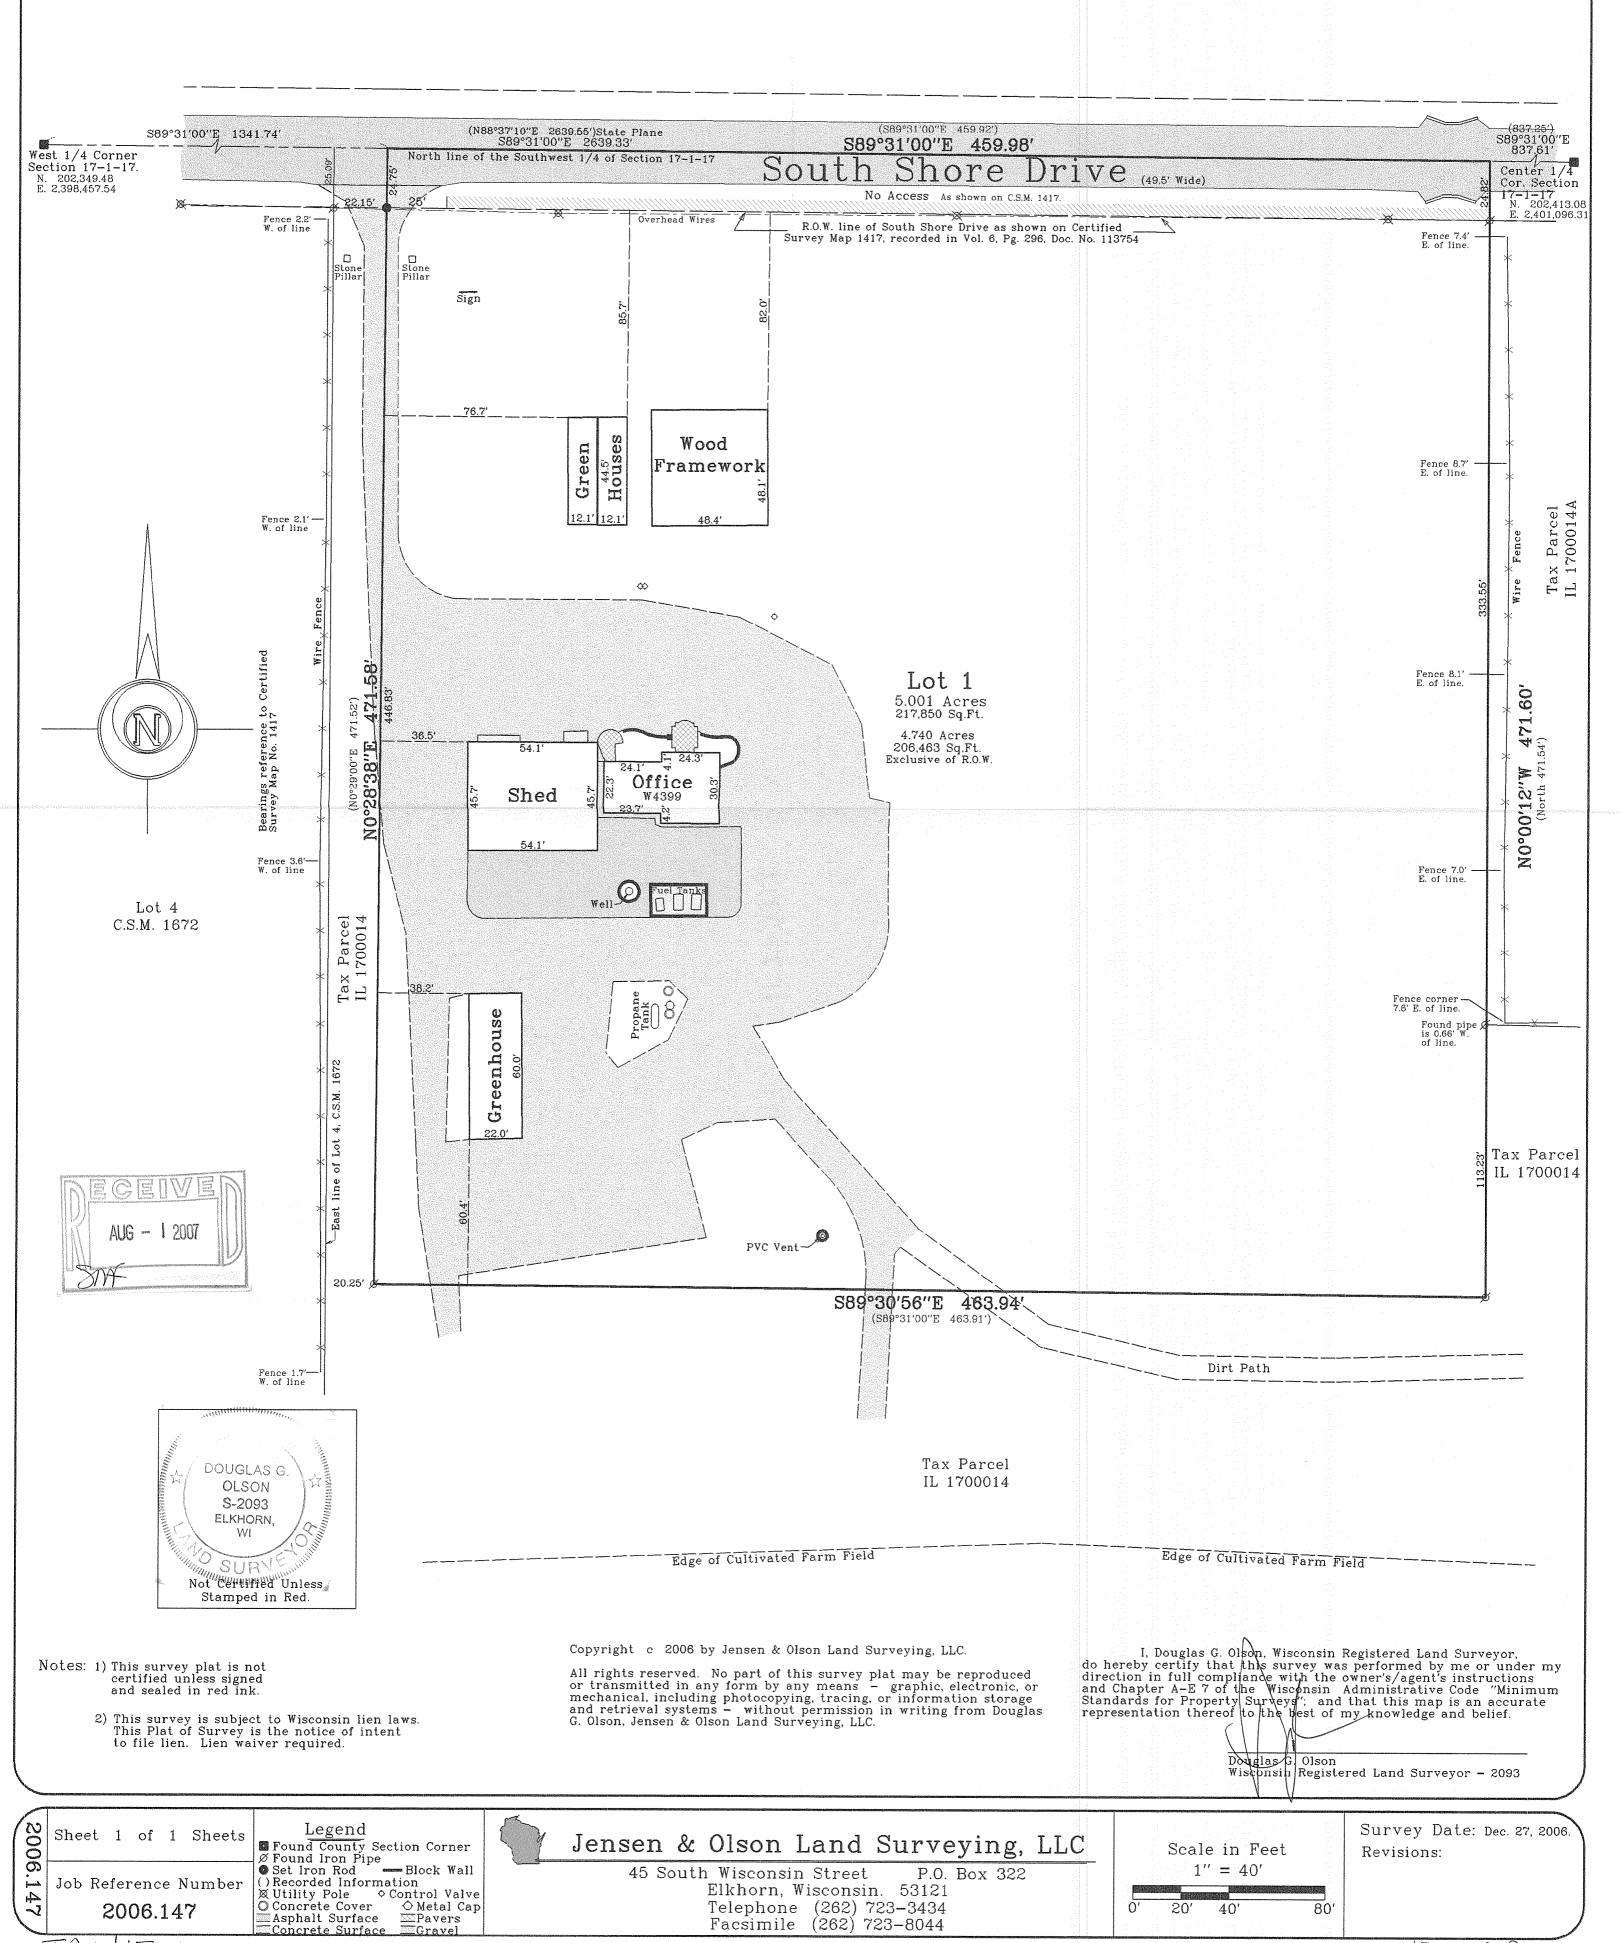

45 South Wisconsin Street

Elkhorn, Wisconsin. 53121 Telephone (262) 723-3434 Facsimile (262) 723-8044

P.O. Box 322

Job Reference Number

2006.147

1'' = 40'

80'