

# DEGEN - FOAT SURVEYING, INC.


100 SOUTH SECOND STREET  
WATERFORD, WISCONSIN 53185  
(262)534-5404 (FAX)534-2022

071160  
071160S1.DWG

## PLAT OF SURVEY

LOTS 13, 14 AND 15, BLOCK 9, SUNSET HILLS SUBDIVISION, LOCATED IN SECTION 4,  
TOWN 1 NORTH, RANGE 17 EAST, TOWN OF LINN, WALWORTH COUNTY, WISCONSIN.

\* REFER TO A CURRENT TITLE REPORT FOR EASEMENTS, RESTRICTIONS OR COVENANTS OF RECORD THAT MAY AFFECT THIS LAND. \*

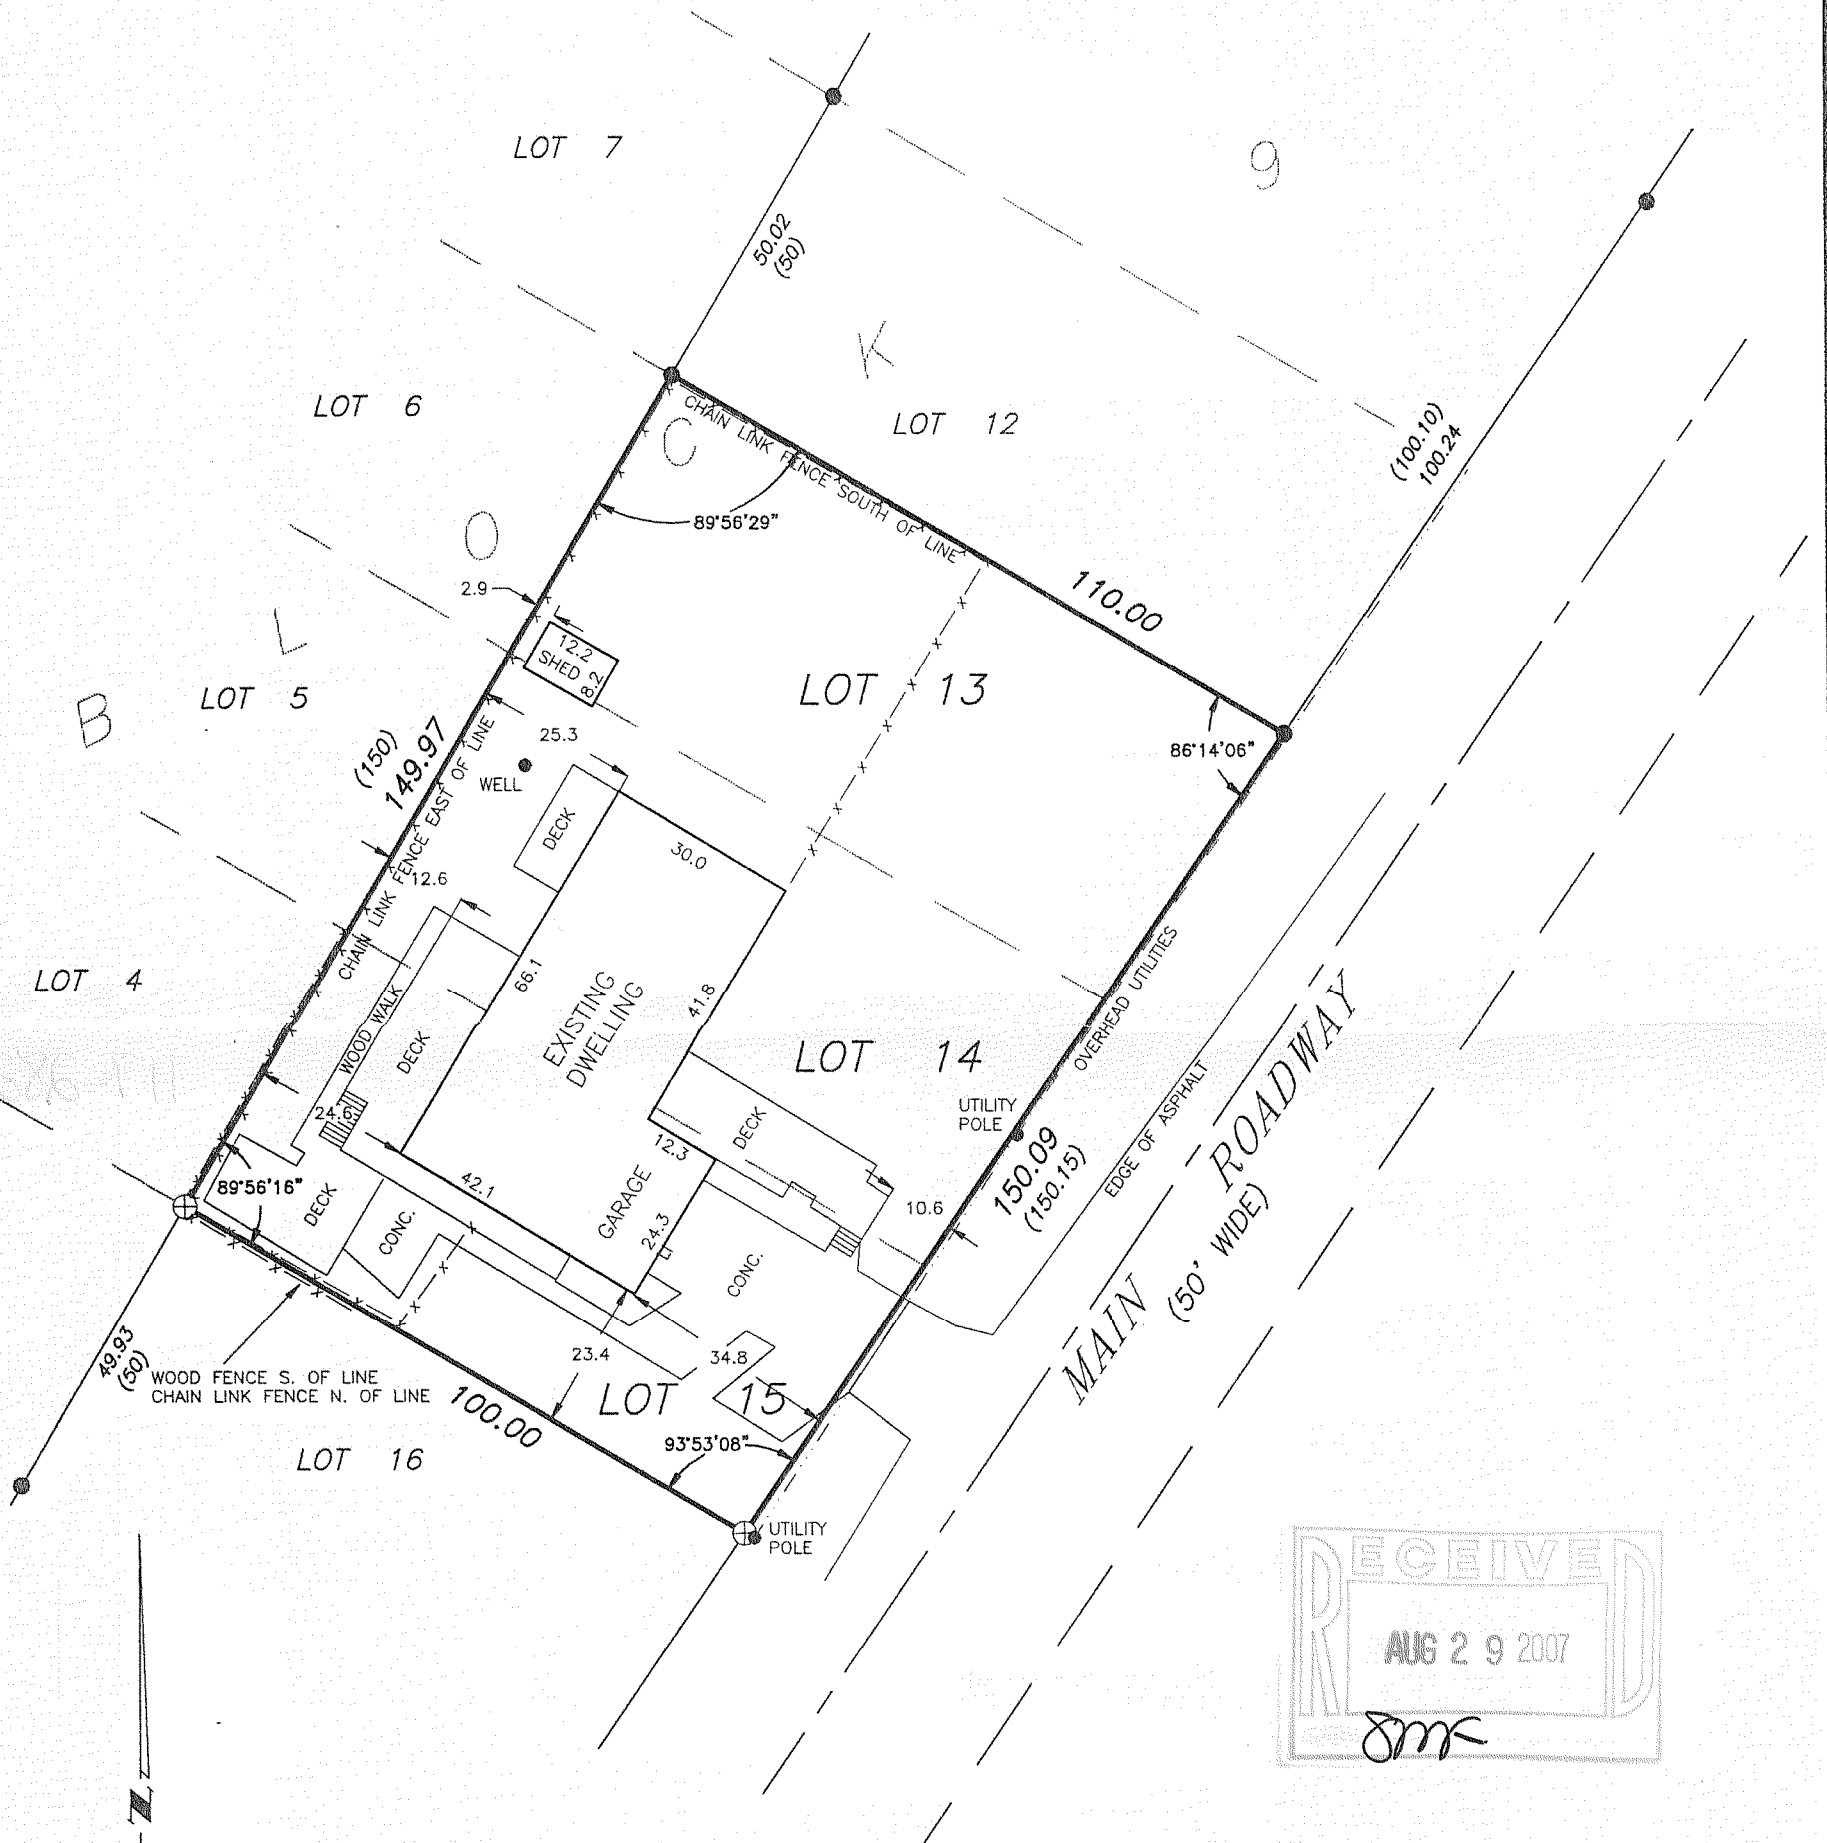


SCALE: 1" = 30'

### LEGEND

- ⊕ - FOUND IRON ROD IN CONCRETE
- - FOUND IRON PIPE
- FENCE
- ( ) - RECORDED AS

SURVEY PREPARED FOR: DON JACOBS  
214 RAYMOND AVE.  
BARRINGTON, IL 60010

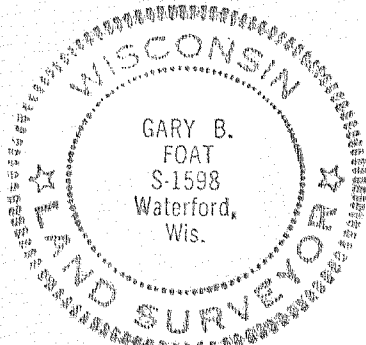

I HEREBY CERTIFY THAT I HAVE SURVEYED THE ABOVE DESCRIBED PROPERTY AND THE ABOVE MAP IS A TRUE REPRESENTATION THEREOF AND SHOWS THE SIZE AND LOCATION OF THE PROPERTY, THE LOCATION OF ALL VISIBLE STRUCTURES AND DIMENSIONS OF ALL PRINCIPAL BUILDINGS THEREON, BOUNDARY FENCES, APPARENT EASEMENTS, ROADWAY AND VISIBLE ENCROACHMENTS, IF ANY.

THIS SURVEY IS MADE FOR THE PRESENT OWNERS OF THE PROPERTY, AND ALSO THOSE WHO PURCHASE, OR GUARANTEE THE TITLE THERETO WITHIN (1) YEAR FROM THE DATE HEREOF.

DATED AT WATERFORD, WI THIS 11th DAY OF JULY 2007

RECERTIFIED

*Gary B. Foat*

ISH-121

117-2824