FARRIS, HANSEN & ASSOC. INC.

7 RIDGWAY COURT- P.O. BOX 437 ELKHORN, WISCONSIN 53121 PHONE (262) 723-2098 FAX (262) 723-5886

LAKE GENEVA, WI.

ORDERED BY: DOWN TO EARTH CONTRACTORS N 19 17 HWY "H"


LOT 7 LEGEND

LOT 8

PLAT OF SURVEY

LOT 9, BLOCK 5

LAKE GENEVA TERRACE SUBDIVISION LOCATED IN SEC. 15, T1N, R17E TOWN OF LINN, WALWORTH COUNTY, WI.

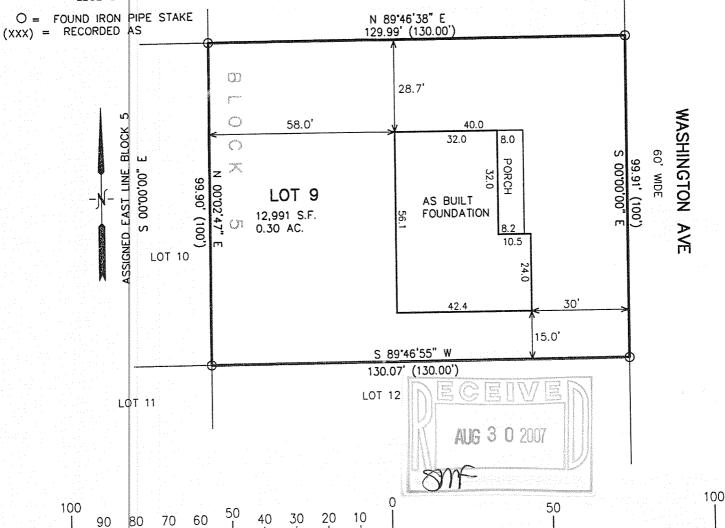

ORIGINAL 1" = 30'MAP SCALE IN FEET

NOTE: COPIES OF THIS MAP TO WHICH THE FOLLOWING CERTIFICATE WILL APPLY SHOW SURVEYOR'S ORIGINAL SEAL AND SIGNATURE IN RED INK. COPIES BY ANY OTHER MEANS MAY HAVE ALTERATIONS WHICH DO NOT REPRESENT THE SURVEYOR'S WORK PRODUCT.

I HEREBY CERTIFY THAT THE ABOVE DESCRIBED PROPERTY HAS BEEN SURVEYED UNDER MY DIRECTION AND THAT THE ABOVE MAP IS A TRUE REPRESENTATION THEREOF AND SHOWS THE SIZE AND LOCATION OF THE PROPERTY AND ITS EXTERIOR BOUNDARIES. THIS SURVEY IS MADE FOR THE USE OF THE PRESENT OWNERS OF THE PROPERTY, AND ALSO THOSE WHO PURCHASE, MORTGAGE, OR GUARANTEE THE TITLE THERETO WITHIN ONE YEAR FROM THE DATE HEREOF HEREOF.

DATED: JUNE 14, 2007

REVISED 08-06-07 TO SHOW AS BUILT FOUNDATION

R.L.S. 2101 PETER S. GORDON

PROJECT NO. 7344 DATED: 06-14-2007 SHEET 1 OF 11 SHEETS

G00%

PETER S

GORDON 8-2101 ELKHORN WI