FARRIS, HANSEN & ASSOCIATES, INC.

ENGINEERING — ARCHITECTURE — SURVEYING
7 RIDGWAY COURT — P.O. BOX 437 — ELKHORN, WISCONSIN 53121
PHONE: (262) 723—2098 FAX: (262) 723—5886

PLAT OF SURVEY

LOTS 18 & 19 OF BLOCK J OF CISCO BEACH SUBDIVISION


LOCATED IN PART OF SECTION 5, TOWN 1 NORTH, RANGE 17 EAST, WALWORTH COUNTY, WISCONSIN

ASSIGNED THE EASTERLY RIGHT
WAY LINE OF GREENLEAF DRIVE
N 00'00'00" E

GREENLEAF DRIVE

\$50' WIDE R.O.W.}

WORK ORDERED BY —
 JIM CONNOLLY
 12615 SOUTH 104th STREET
 PALOS PARK, IL 60464

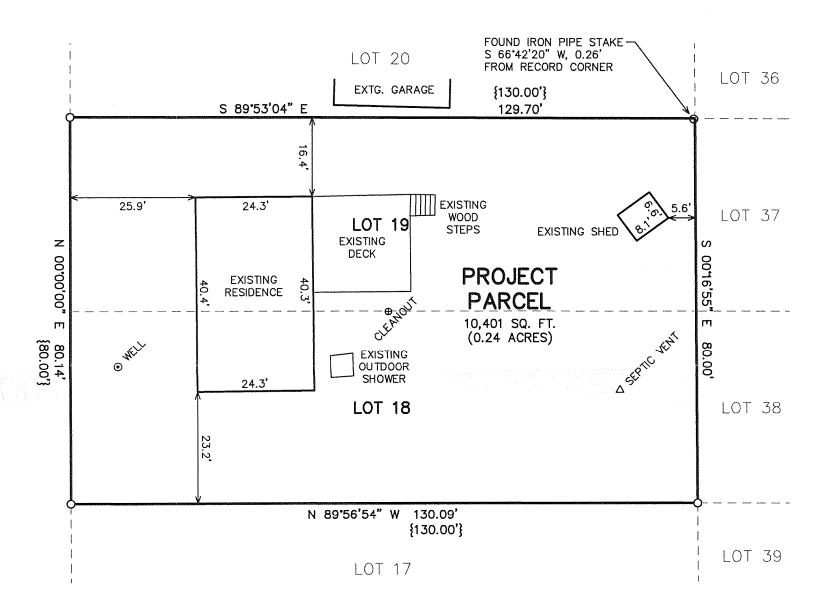

10 5 0 10 20 30 40 50 60 70 80 90 100 MAP SCALE IN FEET ORIGINAL 1" = 20'

NOV = 1 2007


NOTE: COPIES OF THIS MAP TO WHICH THE FOLLOWING CERTIFICATE WILL APPLY SHOW THE SURVEYOR'S ORIGINAL SEAL AND SIGNATURE IN RED INK. COPIES BY ANY OTHER MEANS MAY HAVE ALTERATIONS WHICH DO NOT REPRESENT THE SURVEYOR'S WORK PRODUCT.

I HEREBY CERTIFY THAT THE ABOVE DESCRIBED PROPERTY HAS BEEN SURVEYED UNDER MY DIRECTION AND THAT THE ABOVE MAP IS A TRUE REPRESENTATION THEREOF AND SHOWS THE SIZE AND LOCATION OF THE PROPERTY AND ITS EXTERIOR BOUNDARIES. THIS SURVEY IS MADE FOR THE USE OF THE PRESENT OWNERS OF THE PROPERTY, AND ALSO THOSE WHO PURCHASE, MORTGAGE, OR GUARANTEE THE TITLE THERETO WITHIN ONE YEAR FROM THE DATE HEREOF.

DATED: _____10/12/2007

10/12/2007

PETER S. GORDON R.L.S. 2101

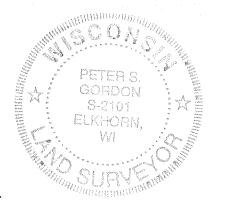

PROJECT: 7462 DATE: 10/12/2007 SHEET 1 OF 1

OCT 15 WIN ICI-232

117 -2867