
HAROLD H. KOLB

REGISTERED PROFESSIONAL LAND SURVEYOR

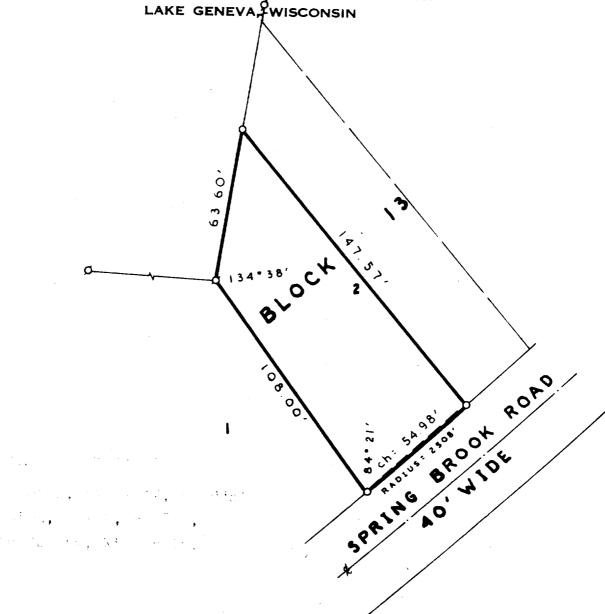

LEGEND

- φ IRON PIPE FOUND
- O IRON PIPE PLACED
- - CONCRETE MONUMENT
- X SPIKE

N



S CALE : 1" = 40'

The Above of the Above of American State of the Above of

I. HAROLD H. KOLB, DO HEREBY CERTIFY THAT I HAVE SURVEYED THE PROPERTY HEREON DESCRIBED ACCORDING TO THE OFFICIAL RECORDS, AND THAT THE PLAT HEREON IS A CORRECT REPRESENTATION OF THE LOT LINES.

Harold W. Kolf

HAROLD H. KOLB

WISCONSIN REGISTERED LAND SURVEYOR, S-187

DATE ___November 10, 197;

IW-65

117-290