


# AS-BUILT MAPPING PLAT OF SURVEY

LOT 5 OF S.B. CHAPIN'S SUBDIVISION  
 LOCATED IN PART OF SECTION 4, TOWN 1 NORTH,  
 RANGE 17 EAST, WALWORTH COUNTY, WISCONSIN

**FH**

WORK ORDERED BY -  
 SUSAN CICORA  
 2911 OAK BROOK HILLS ROAD  
 OAK BROOK, IL 60523

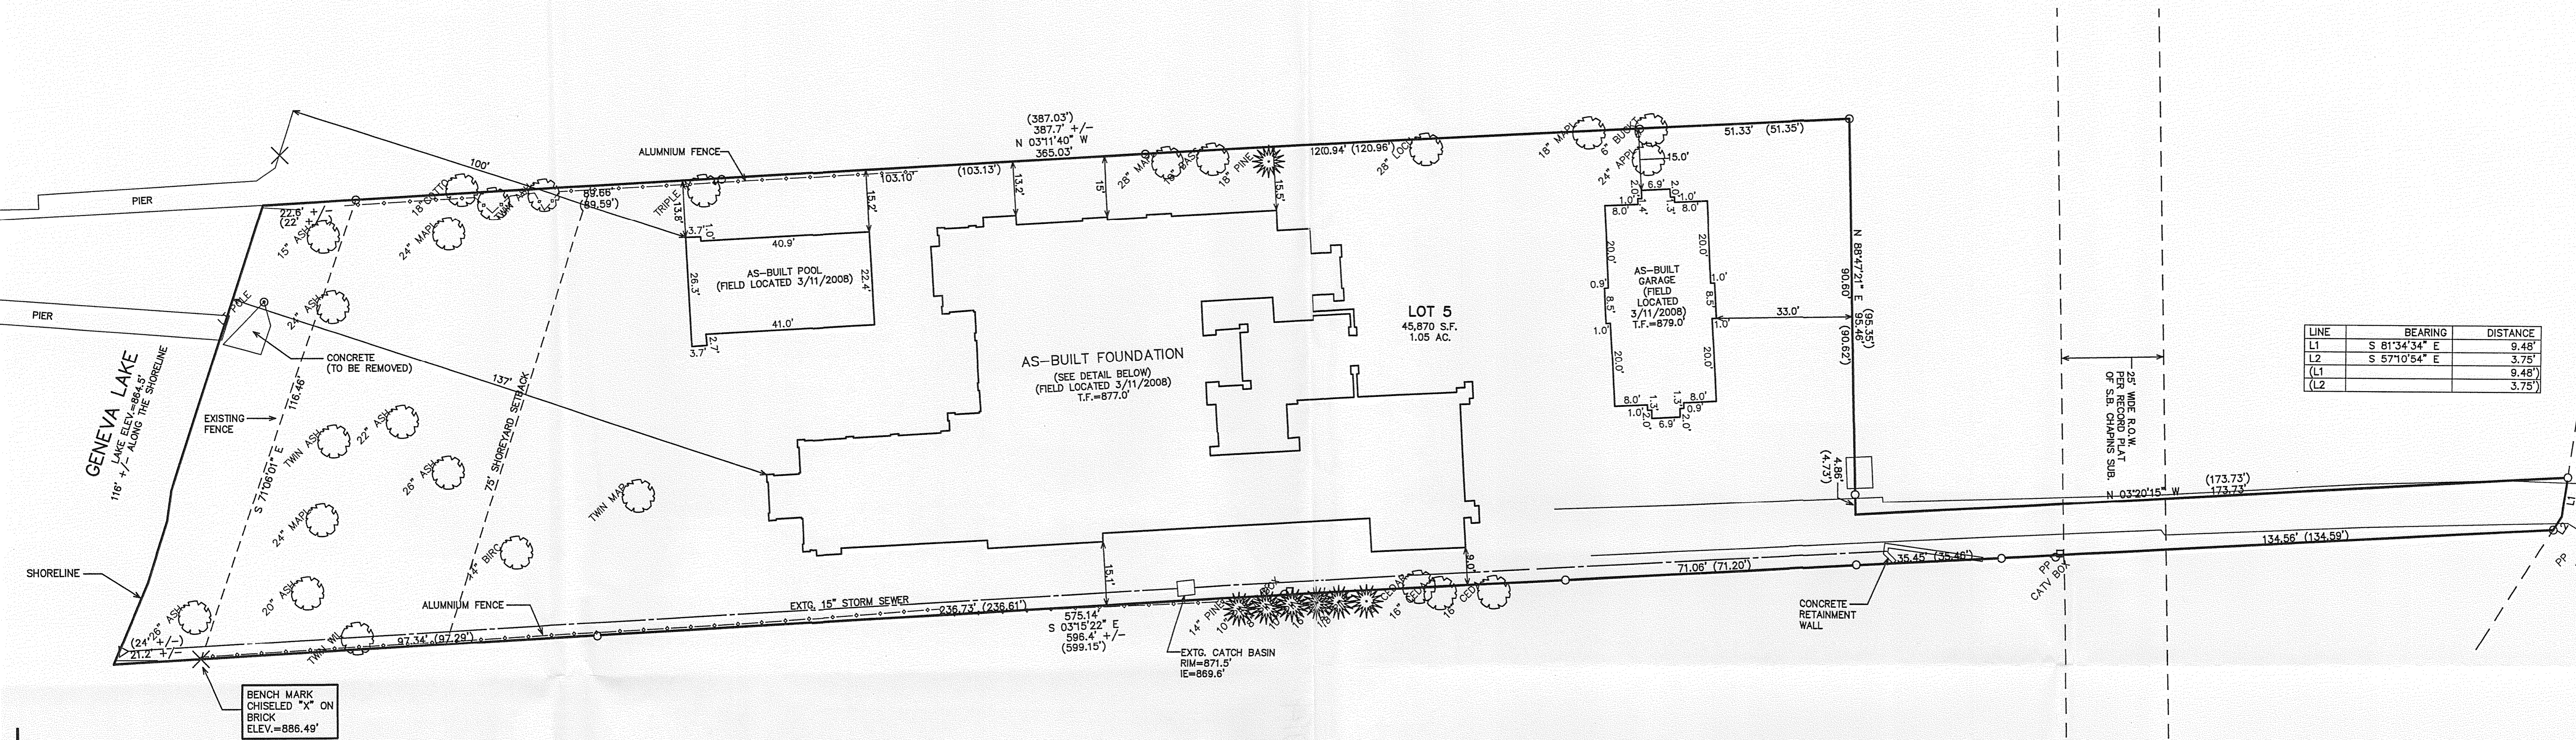

BENCH MARK  
 CHISELED "X" ON  
 BRICK  
 ELEV.=886.49'

**LEGAL DESCRIPTION:**

A parcel of land located in Section numbered Four (4), Township numbered One (1) North, Range numbered seventeen (17) East, Walworth County, Wisconsin, described as follows, to-wit: Beginning at the Southwest corner of Lot 5 of S.B. Chapin's Subdivision, which point is on the shore of Geneva Lake; thence North along the West line of said Lot 5, 390.71 feet to a point that is located 76 feet South of the North line of said Subdivision; thence East parallel to the North line of said Subdivision 95.35 feet; thence North parallel to the East line of said Lot 5, 174.23 feet; thence South 77° 24' East 9.27 feet; thence South 54° 49' East 3.75 feet; thence South along a line that is the Northerly extension of the East line of said Lot 5 and along the East line of said Lot 5, 599.13 feet to the shore of Geneva Lake; thence Westerly along the shore to the place of beginning.

Tax Key No. ICH 00002A1 IL 400012A

NOTE:  
 SOUTHERN GAS EASEMENT RECORDED IN VOL. 581 ON PG. 312  
 AS DOC. NO. 541512 CANNOT BE ACCURATELY DEPICTED ON PLAT;  
 REFERENCE RECORD DOCUMENT  
 THE PUBLIC HAS THE RIGHTS IN AND TO THE FOOTPATH AROUND  
 GENEVA LAKE.

LEGEND

○ = FOUND IRON PIPE STAKE

✕ = FOUND CHISELED "X"

(XXX) = RECORDED AS




NOTE: COPIES OF THIS MAP TO WHICH THE FOLLOWING CERTIFICATE WILL APPLY SHOW THE SURVEYOR'S ORIGINAL SEAL AND SIGNATURE IN RED INK. COPIES BY ANY OTHER MEANS MAY HAVE ALTERATIONS WHICH DO NOT REPRESENT THE SURVEYOR'S WORK PRODUCT.


I HEREBY CERTIFY THAT THE ABOVE DESCRIBED PROPERTY HAS BEEN SURVEYED UNDER MY DIRECTION AND THAT THE ABOVE MAP IS A TRUE REPRESENTATION THEREOF AND SHOWS THE SIZE AND LOCATION OF THE PROPERTY, ITS EXTERIOR BOUNDARIES, THE LOCATION OF ALL VISIBLE STRUCTURES, AND DIMENSIONS OF ALL PRINCIPAL BUILDINGS THEREON, BOUNDARY FENCES, APPARENT EASEMENTS, ROADWAYS, AND VISIBLE ENCROACHMENTS, IF ANY. THIS SURVEY IS MADE FOR THE USE OF THE PRESENT OWNERS OF THE PROPERTY, AND ALSO THOSE WHO PURCHASE, MORTGAGE, OR GUARANTEE THE TITLE THERETO WITHIN ONE YEAR FROM THE DATE HEREOF.

DATED: JULY 26, 2004

*Peter S. Gordon*  
 PETER S. GORDON

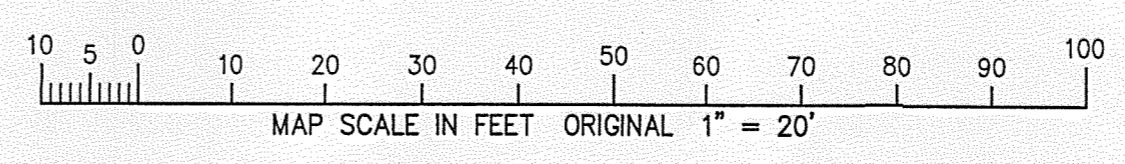

AS-BUILT FOUNDATION  
 DETAIL  
 SCALE: 1/12"=1'

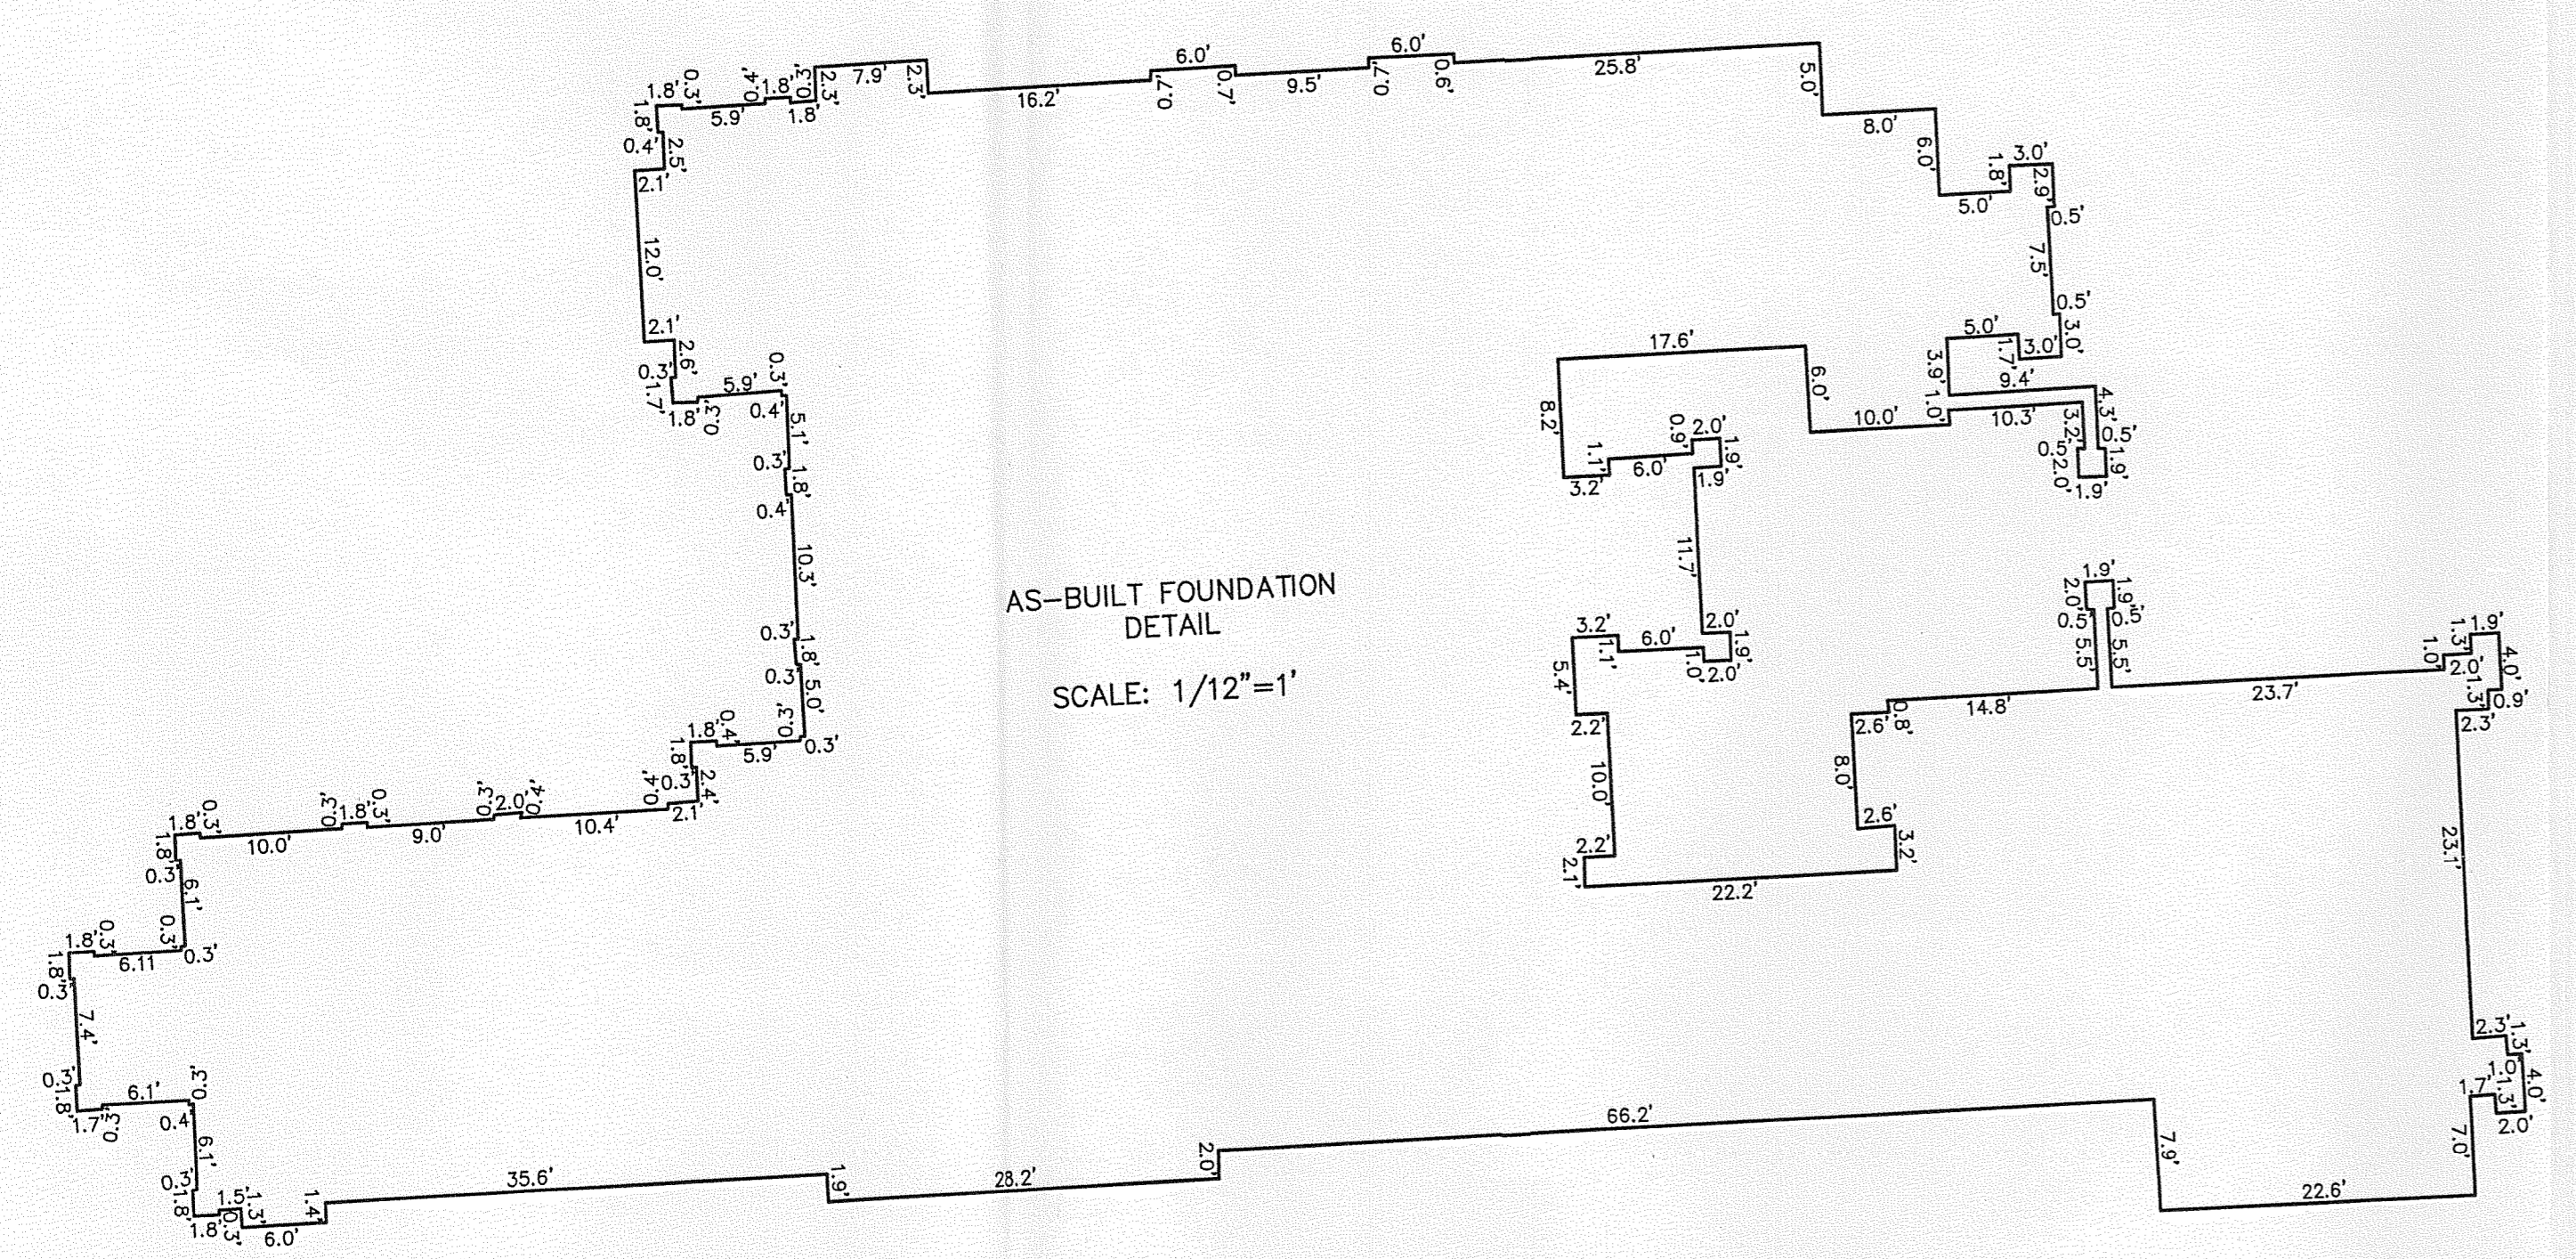

**FARRIS, HANSEN & ASSOCIATES, INC.**  
 ENGINEERING - ARCHITECTURE - SURVEYING  
 7 RIDGWAY COURT P.O. BOX 437  
 ELKHORN, WISCONSIN 53121  
 OFFICE: (262) 723-2098 FAX: (262) 723-5886

REVISIONS

7/11/2007-KB  
 SITE GRADING,  
 DRAINAGE, & EROSION  
 CONTROL PLAN

8/1/2007-KB  
 MISC. ADVANCEMENT

8/7/2007-KB  
 REVISED TOP OF  
 FOUNDATION GRADE

8/30/2007-KB  
 MOVE POOL AND MISC.  
 GRADING CHANGES

3/12/2008-KB  
 TO SHOW SIZE &  
 LOCATION OF AS-BUILT  
 RESIDENCE/GARAGE/  
 PPOOL

PROJECT NO.  
 6605

DATE  
 07/26/04

SHEET NO.  
 1 OF 1

ICH-2A1

117-2914