
PREPARED FOR BEAA SHEEHAN KEEFE REALESTATE 751 GENEVA PARKWAY LAKE GENEVA WI. 53147

PLAT OF SURVEY

-OF-

LOT 20, BLOCK 4 LAKE GENEVA TERRACE, A SUBDIVISION LOCATED IN SECTION 15, TOWN 1 NORTH, RANGE 17 EAST, WALWORTH COUNTY, WISCONSIN.

KROTT SURVEYING INC. N3705 WILLOW BEND LANE LAKE GENEVA WI. 53147 PHONE # (262)248-3697 FAX # (262)249-0639

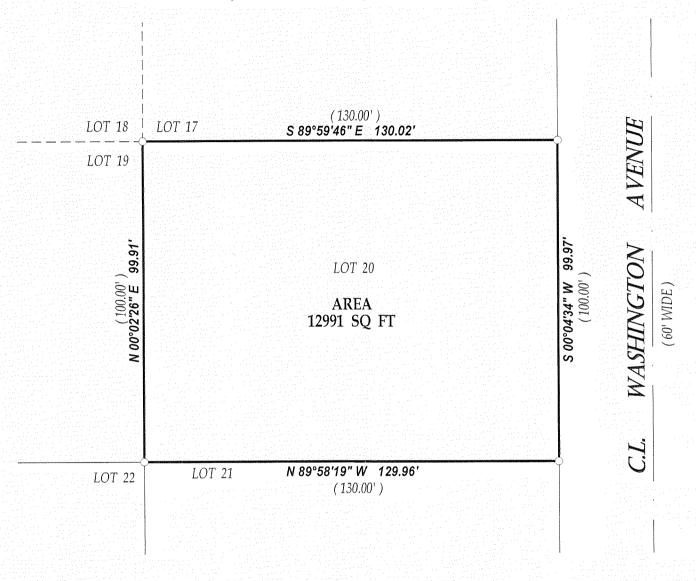

LEGEND

O FOUND IRON PIPE

Ø POWER POLE


— *E*— OVERHEAD WIRES

(XX) RECORDED AS


TAX ID # ILGT00018A JOB # 08-060 DATED THIS THE 31st DAY OF MARCH 2008. COMPARE LEGAL DESCRIPTION ABOVE AND DRAWING WITH DEED. FOR BUILDING RESTRICTIONS AND EASEMENTS NOT SHOWN, REFER TO DEED, ABSTRACT SOURCES AND LOCAL MUNICIPAL CODES. NOTIFY THE SURVEYOR IMMEDIATELY OF ANY DISCREPANCY.

"I hereby certify that I have surveyed the above described property and that the above map is a true representation thereof and shows the size and location of all visible structures, apparent easements and encroachments if any."

This survey is made for the present owners of the property, and those who purchase, mortgage, or guarentee the title thereto, within one year from

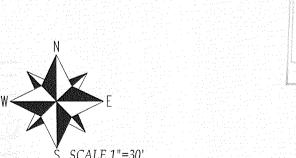

30

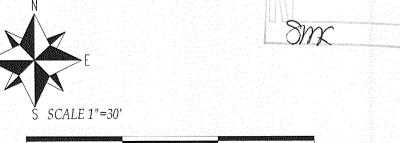

60

APR | 8 2008



JOHN KROTT S - 2258 Wisconsin Registered Land Surveyor (original if signed in red)