PREPARED FOR MARIANE WEIGLEY PLAT OF **SURVEY**

-OF-

PARCEL "B" LOT 12, BLOCK 4 LAKE GENEVA TERRACE, A SUBDIVISION LOCATED IN SECTION 15, TOWN 1 NORTH, RANGE 17 EAST, WALWORTH COUNTY, WISCONSIN. SAID PARCEL CONTAINING 12,980 SQ FT MORE OR LESS.


KROTT SURVEYING INC. N3705 WILLOW BEND LANE LAKE GENEVA WI. 53147 PHONE # (262)248-3697 FAX # (262)249-0639

PARCEL "A" LOCATED IN SECTION 15, TOWN 1 NORTH, RANGE 17 EAST, WALWORTH COUNTY, WISCONSIN. SAID PARCEL CONTAINING

LOT 11, BLOCK 4 LAKE GENEVA TERRACE, A SUBDIVISION

12,981 SQ FT MORE OR LESS.

NOTE: THIS IS A PARCEL SPLIT

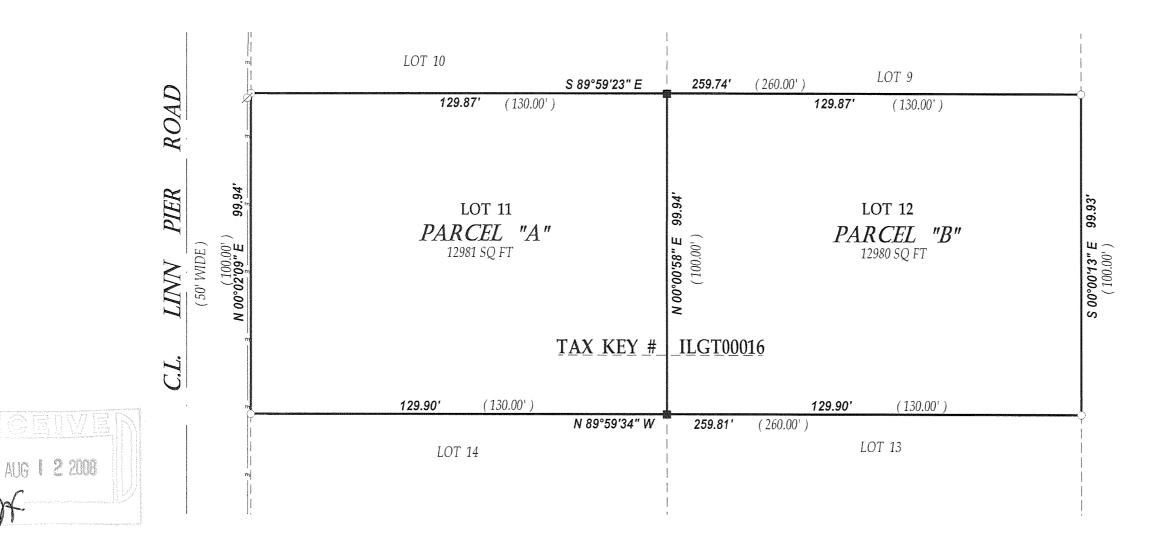

LEGEND

O FOUND IRON PIPE

Ø POWER POLE

— *E*— OVERHEAD WIRES

(XX) RECORDED AS


JOB # 08-058

TA(X ID # ILGT00016

COMPARE LEGAL DESCRIPTION ABOVE AND DRAWING WITH DEED. FOR BUILDING RESTRICTIONS AND EASEMENTS NOT SHOWN, REFER TO DEED, ABSTRACT SOURCES AND LOCAL MUNICIPAL CODES. NOTIFY THE SURVEYOR IMMEDIATELY OF ANY DISCREPANCY.

"I hereby certify that I have surveyed the above described property and that the above map is a true representation thereof and shows the size and location of all visible structures, apparent easements and encroachments

This survey is made for the present owners of the property, and those who purchase, mortgage, or guarentee the title thereto, within one year from the date hereof.

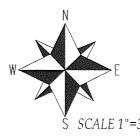

SCALE 1"=30" 30 60 90



DATED THIS 17th, DAY OF JULY, 2008

JOHN KROTT S - 2258 Wisconsin Registered Land Surveyor (original if signed in red)