



WORK ORDERED BY -
LINDA JOHNSTON
6 ROCK RIDGE ROAD
BARRINGTON HILLS, IL 60010

FARRIS, HANSEN & ASSOCIATES, INC.
ENGINEERING - ARCHITECTURE - SURVEYING
7 RIDGWAY COURT P.O. BOX 437
ELKHORN, WISCONSIN 53121
OFFICE: (262) 723-2098 FAX: (262) 723-5886

REVISIONS

PROJECT NO.
6511
DATE:
07/21/04
SHEET NO.
1 OF 1


PLAT OF SURVEY

TAX PARCELS IW-18, IW-17, AND PART OF LOT "X"
LOCATED IN SECTION 9, TOWN 1 NORTH, RANGE 17 EAST,
WALWORTH COUNTY, WISCONSIN

LEGAL DESCRIPTION


A portion of Lot 12 of Block 1 and a portion of Lot "X" of Wooddale Addition located in the Section 9, Town 1 North, Range 17 East, Town of Linn, Walworth County, Wisconsin, described as follows: beginning at an iron pipe stake at the Southeast corner of Lot 12 of said Wooddale Addition; thence S 03° 39' 00" E, 45.10 feet to an iron pipe stake; thence N 78° 47' 47" W, 12.92 feet along said Southerly line of said Lot "X"; thence continue, S 78° 27' 09" W 41.08 feet to an iron pipe stake; thence 20° 28' 40" W, 39.63 to the South line of said Lot 12 thence S 77° 11' 21" W, 9.78 feet; thence N 06° 52' 28" W, 184.7 feet, more or less, to the shore of Geneva Lake; thence Easterly along shoreline, 87 feet, more or less, thence S. 03° 39' 00" E, 178.4 feet, more or less to the point of beginning.

Tax Key No. IW 00018


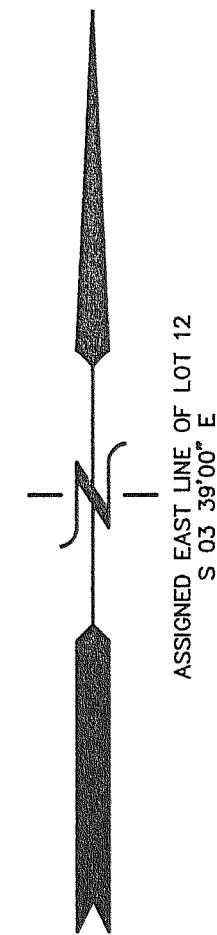


- LEGEND
- = FOUND IRON PIPE STAKE
 - = SET IRON REBAR STAKE
 - (XXX) = RECORDED AS

LINE	BEARING	DISTANCE
L1	N 78°47'47" W	12.92
L2	S 77°11'21" W	9.78
L3	N 61°35'50" E	18.80

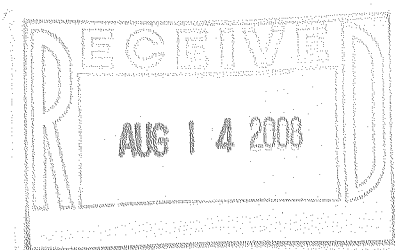

IW-18

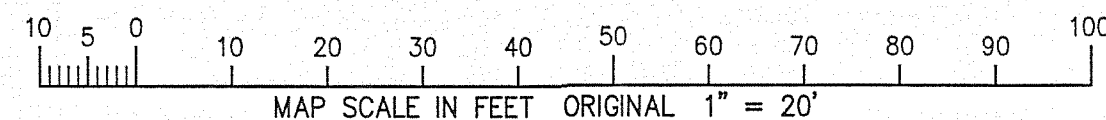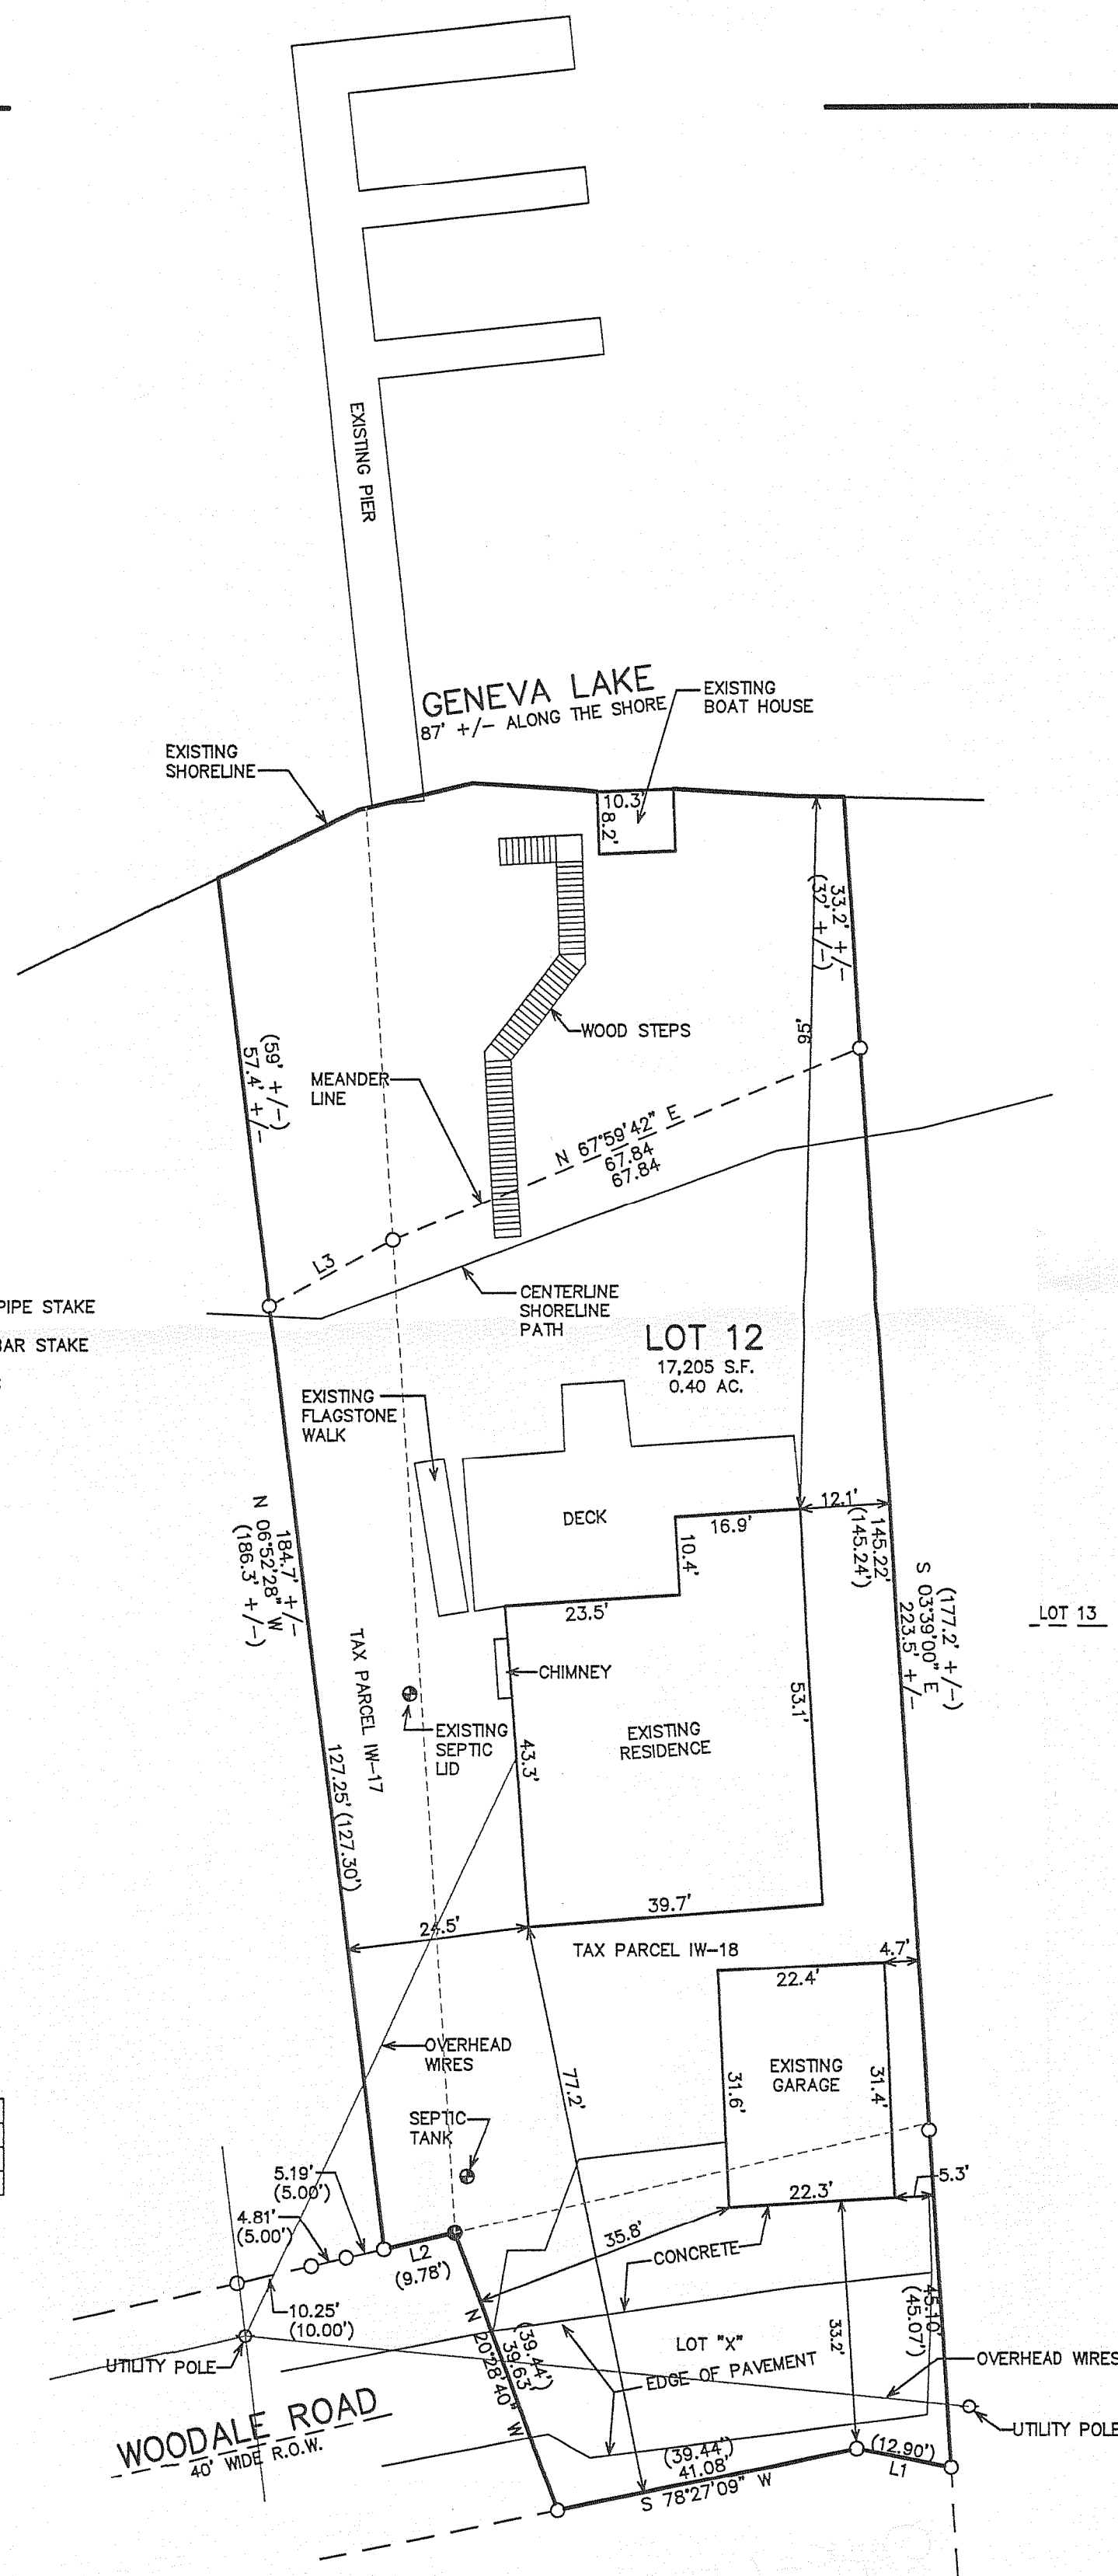

NOTE: COPIES OF THIS MAP TO WHICH THE FOLLOWING CERTIFICATE WILL APPLY SHOW THE SURVEYOR'S ORIGINAL SEAL AND SIGNATURE IN RED INK. COPIES BY ANY OTHER MEANS MAY HAVE ALTERATIONS WHICH DO NOT REPRESENT THE SURVEYOR'S WORK PRODUCT.

I HEREBY CERTIFY THAT THE ABOVE DESCRIBED PROPERTY HAS BEEN SURVEYED UNDER MY DIRECTION AND THAT THE ABOVE MAP IS A TRUE REPRESENTATION THEREOF AND SHOWS THE SIZE AND LOCATION OF THE PROPERTY, ITS EXTERIOR BOUNDARIES, THE LOCATION OF ALL VISIBLE STRUCTURES, AND DIMENSIONS OF ALL PRINCIPLE BUILDINGS THEREON, BOUNDARY FENCES, APPARENT EASEMENTS, ROADWAYS, AND VISIBLE ENCROACHMENTS, IF ANY. THIS SURVEY IS MADE FOR THE USE OF THE PRESENT OWNERS OF THE PROPERTY, AND ALSO THOSE WHO PURCHASE, MORTGAGE, OR GUARANTEE THE TITLE THERETO WITHIN ONE YEAR FROM THE DATE HEREOF.

DATED: JULY 9, 2008

Peter S. Gordon
PETER S. GORDON

REVISED 03-24-2006
TO SHOW SIZE & LOCATION OF
PROPOSED ADDITION AND
100 YEAR FLOOD LINE

REVISED: 7/9/2008-KB
UPDATE TO TITLE SPECS.



117-2983