

# LAND-MARK SURVEYING

## Mark L. Miritz



Wisconsin Registered Land Surveyor S-2582

N9330 Knuteson Drive  
Whitewater, WI 53190  
Phone: (262) 495-3284  
FAX: (262) 495-8421  
LAND-MARKSURVEYING.COM

## PLAT OF SURVEY

LOT 3 OF CERTIFIED SURVEY MAP NO. 1323 AS RECORDED IN VOLUME 6, PAGE 128 OF WALWORTH CO. CERTIFIED SURVEYS, LOCATED IN PART OF THE SOUTHWEST 1/4 AND PART OF THE NORTHWEST 1/4 OF SECTION 14, ALL IN TOWN 1 NORTH, RANGE 17 EAST, LINN TOWNSHIP, WALWORTH COUNTY, WISCONSIN.

OWNERS: ANDROV CARLSON JR.  
SHEREE CARLSON  
N1716 DURAND LANE  
LAKE GENEVA, WI 53147

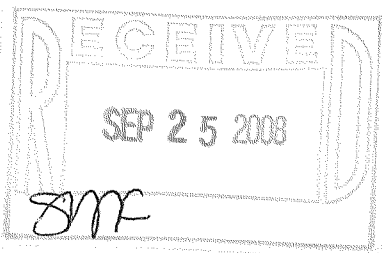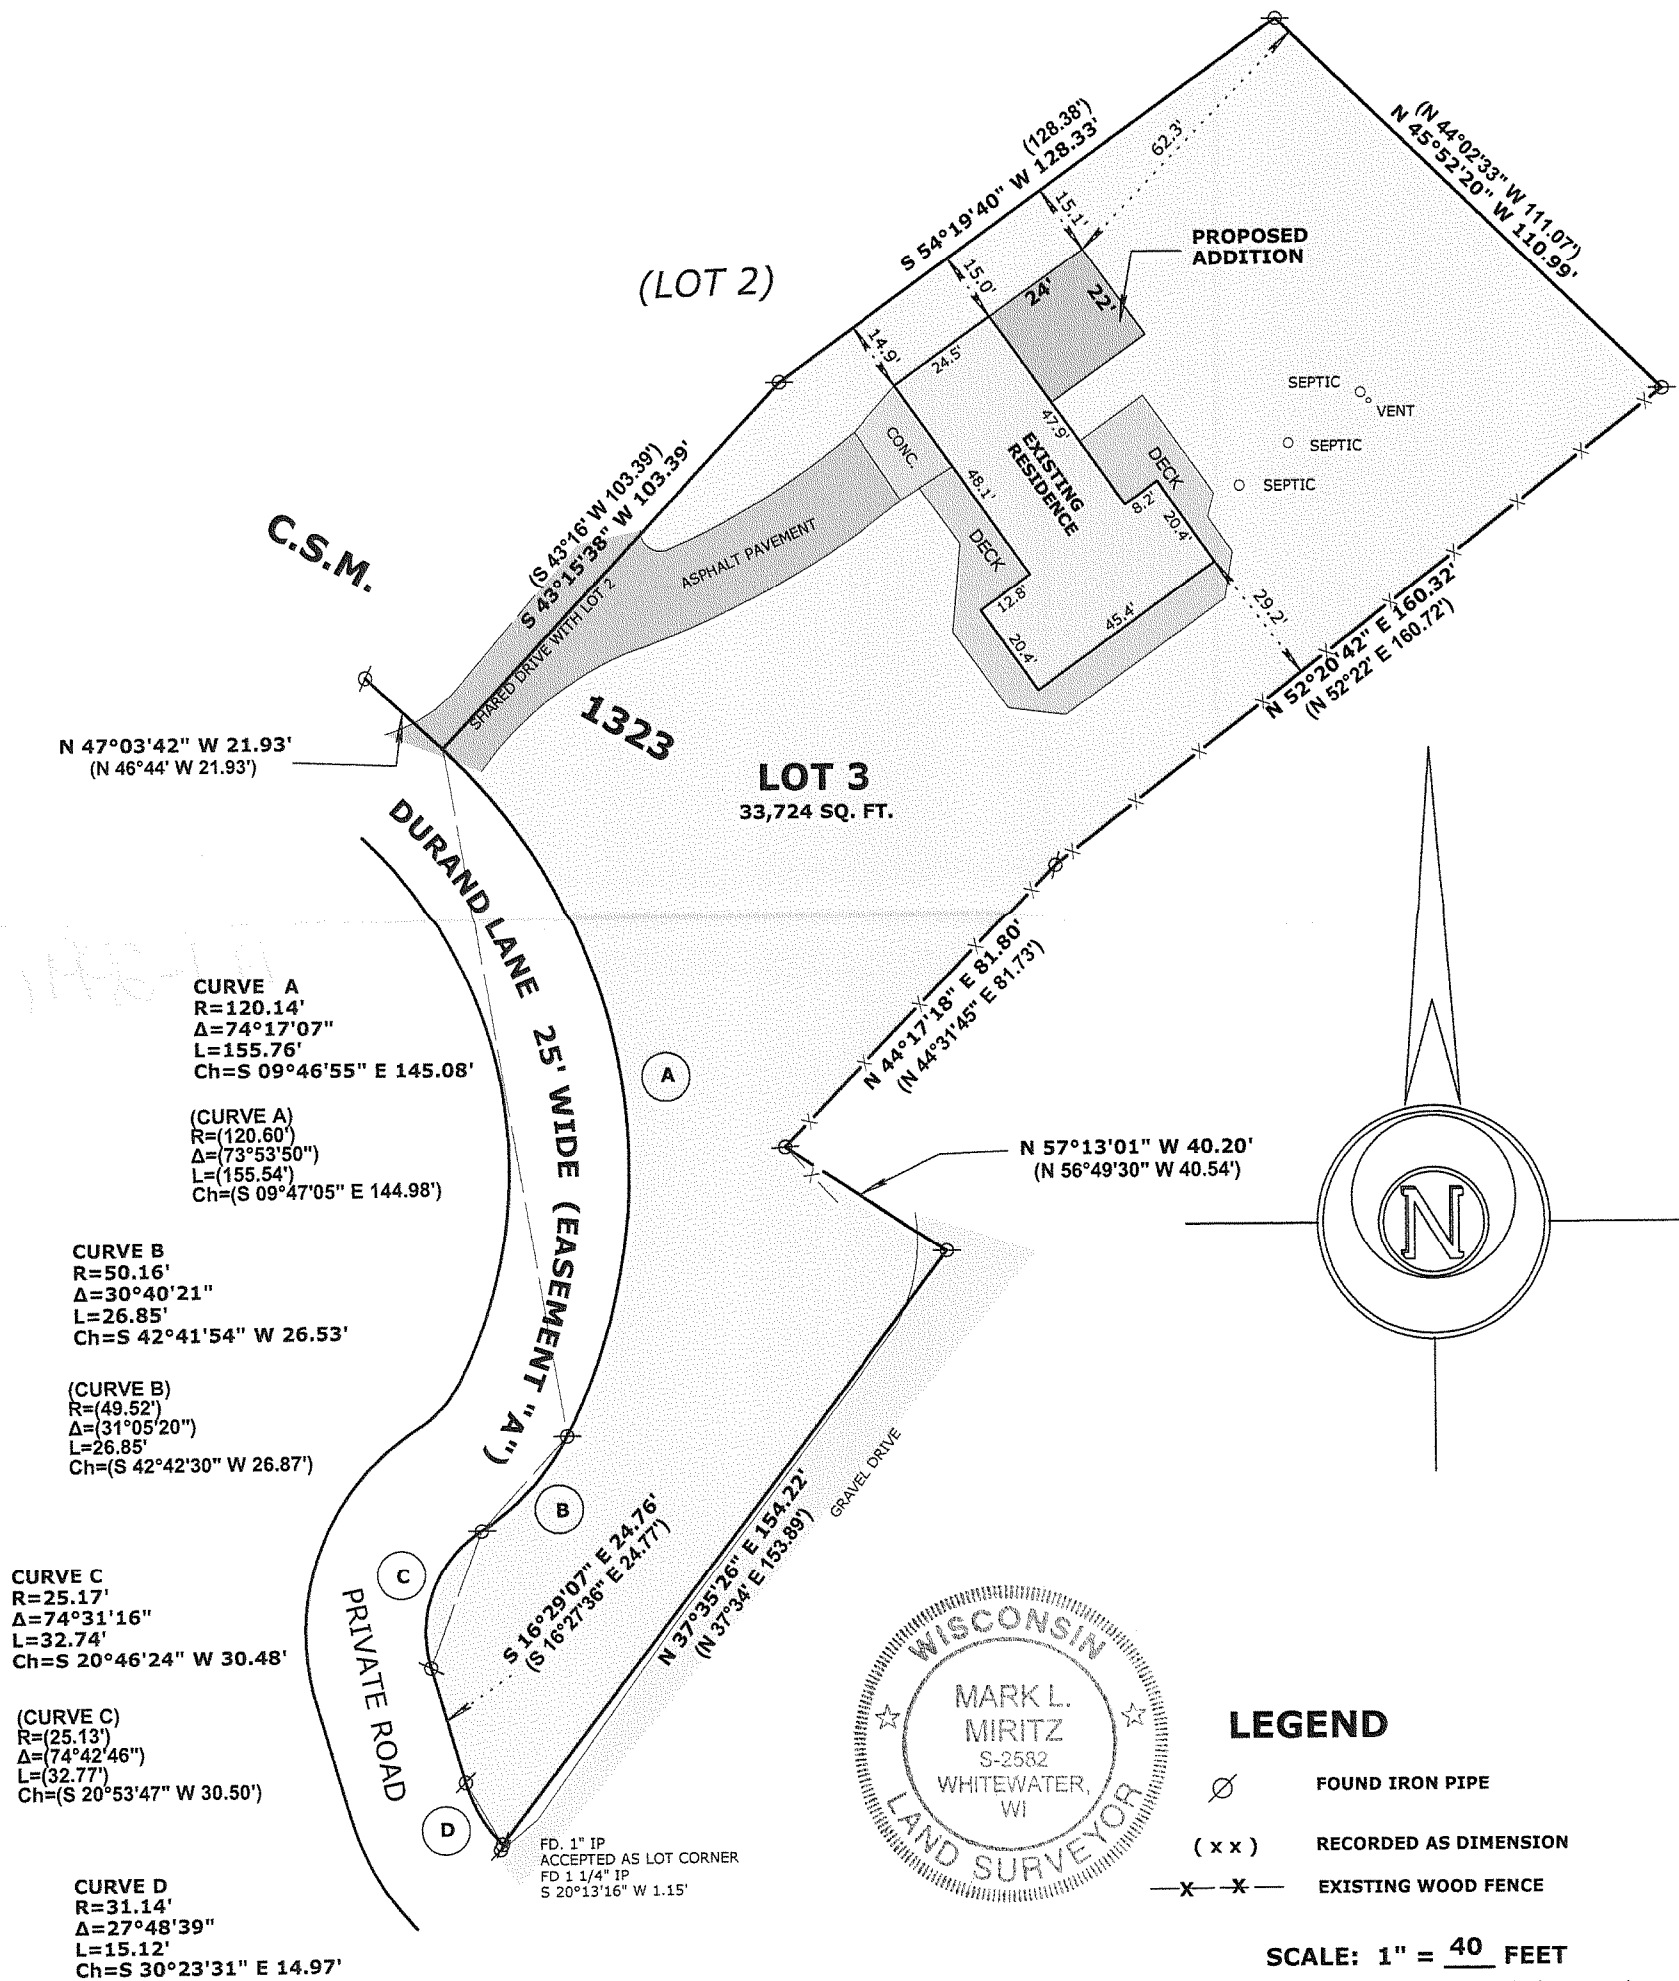

MARK L. MIRITZ  
WISCONSIN REGISTERED  
LAND SURVEYOR S-2582

DATE: JULY 10, 2008 JOB NO. 08.609

IA 1323-3

117-2991